



ان ايه آر كيتكس للاستشارات الهندسية
NA ARCHITECTS ENGINEERING CONSULTANCY

OFFICE 2601 / THE EXCHANGE TOWER
BUSINESS BAY - DUBAI - U.A.E
TEL: 04-2777820 P.O.BOX- 237347
www.naarchitects.net

PLOT NO.	IC3-H-40	LOCATION/BLOCK NAME	IC-PHASE 3
AREA OF PLOT	2773.54 SQ.M.	PROPERTY TITLE	RESI. BUILDING
NO. OF FLOORS ALLOWED	---	NO. FO FLOORS PROPOSED	G+1P+7
LAND USE ALLOWED	RESIDENTIAL APT.	LAND USE PROPOSED	RESIDENTIAL
PLOT COVERAGE ALLOWED	---	PLOT COVERAGE PROPOSED	53.12%
		FLOOR AREA RATIO PROPOSED	2.537%
	RESIDENTIAL		
	AS BUILT		
	PROPOSED BUILDING G+1P+7+ROOF - AS BUILT		
PARKING REQUIRED	96	EXISTING BUILT UP AREA	-NIL-
EXISTING PARKING	-NIL-	APPROVED AREA	-NIL-
ADDITIONAL PARKING	-NIL-	NOT APPROVED AREA	-NIL-
		DEMOLISHED AREA	-NIL-
		ADDITIONAL AREA	-NIL-
TOTAL PARKING PROPOSED	94 NO'S	TOTOAL BUILT UP AREA	11064.08 SQ.M

BUILDING BUILT UP AREA		
FLOORS	APPROVED	REVISED
GROUND FLOOR	2008.45	2008.45
PODIUM FLOOR	1990.00	1453.95
1st FLOOR	1436.10	1234.12
2nd & 3rd FLOOR (1240.09X2)	2480.18	2480.18
4th & 5th FLOOR (1035.67X2)	2071.34	2071.34
6th FLOOR	884.88	884.88
7th FLOOR	858.30	881.70
ROOF FLOOR	49.46	49.46
TOTAL BUILT UP AREA	11778.71 SQ.M	11064.08 SQ.M
COMPOUND WALL RMT.	(701')RFT	
TOTAL BUILDING HEIGHT	(32.35 MT)	
BUILDING NOTES		
YES	MECHANICAL VENTILATION TO BE PROVIDED AS PER ASHRAE STANDARDS	




OWNER'S NAME & SIGNATURE	CONSULTANT'S SIGNATURE & DATE	DESIGNER	NAME	REGISTER	AREA
 MR. MASOOD ABDULLA MOHD ABDULAZIZ AL ZAROONI	 (MANAGER)	ARCHITECT	ABDELGHANI	105832	
		ARCHITECT			
		STRUCTURE	ABDULRAHMAN	111283	
		STRUCTURE	FARHAN	106198	
		STRUCTURE	FAHAD		
		SERVICES			


FOR TRAKHEES USE ONLY

PLUMBING APPROVAL	ROAD APPROVAL <input type="checkbox"/>	CIVIL DEFENCE APPROVAL	ENVIRONMENT APPROVAL	BUILDING NUMBER
				STREET NUMBER
				STREET NAME

NAKHEEL STAMP & APPROVAL	MUNICIPALITY CONDITIONS
	1-
	2-
	3-
	4-

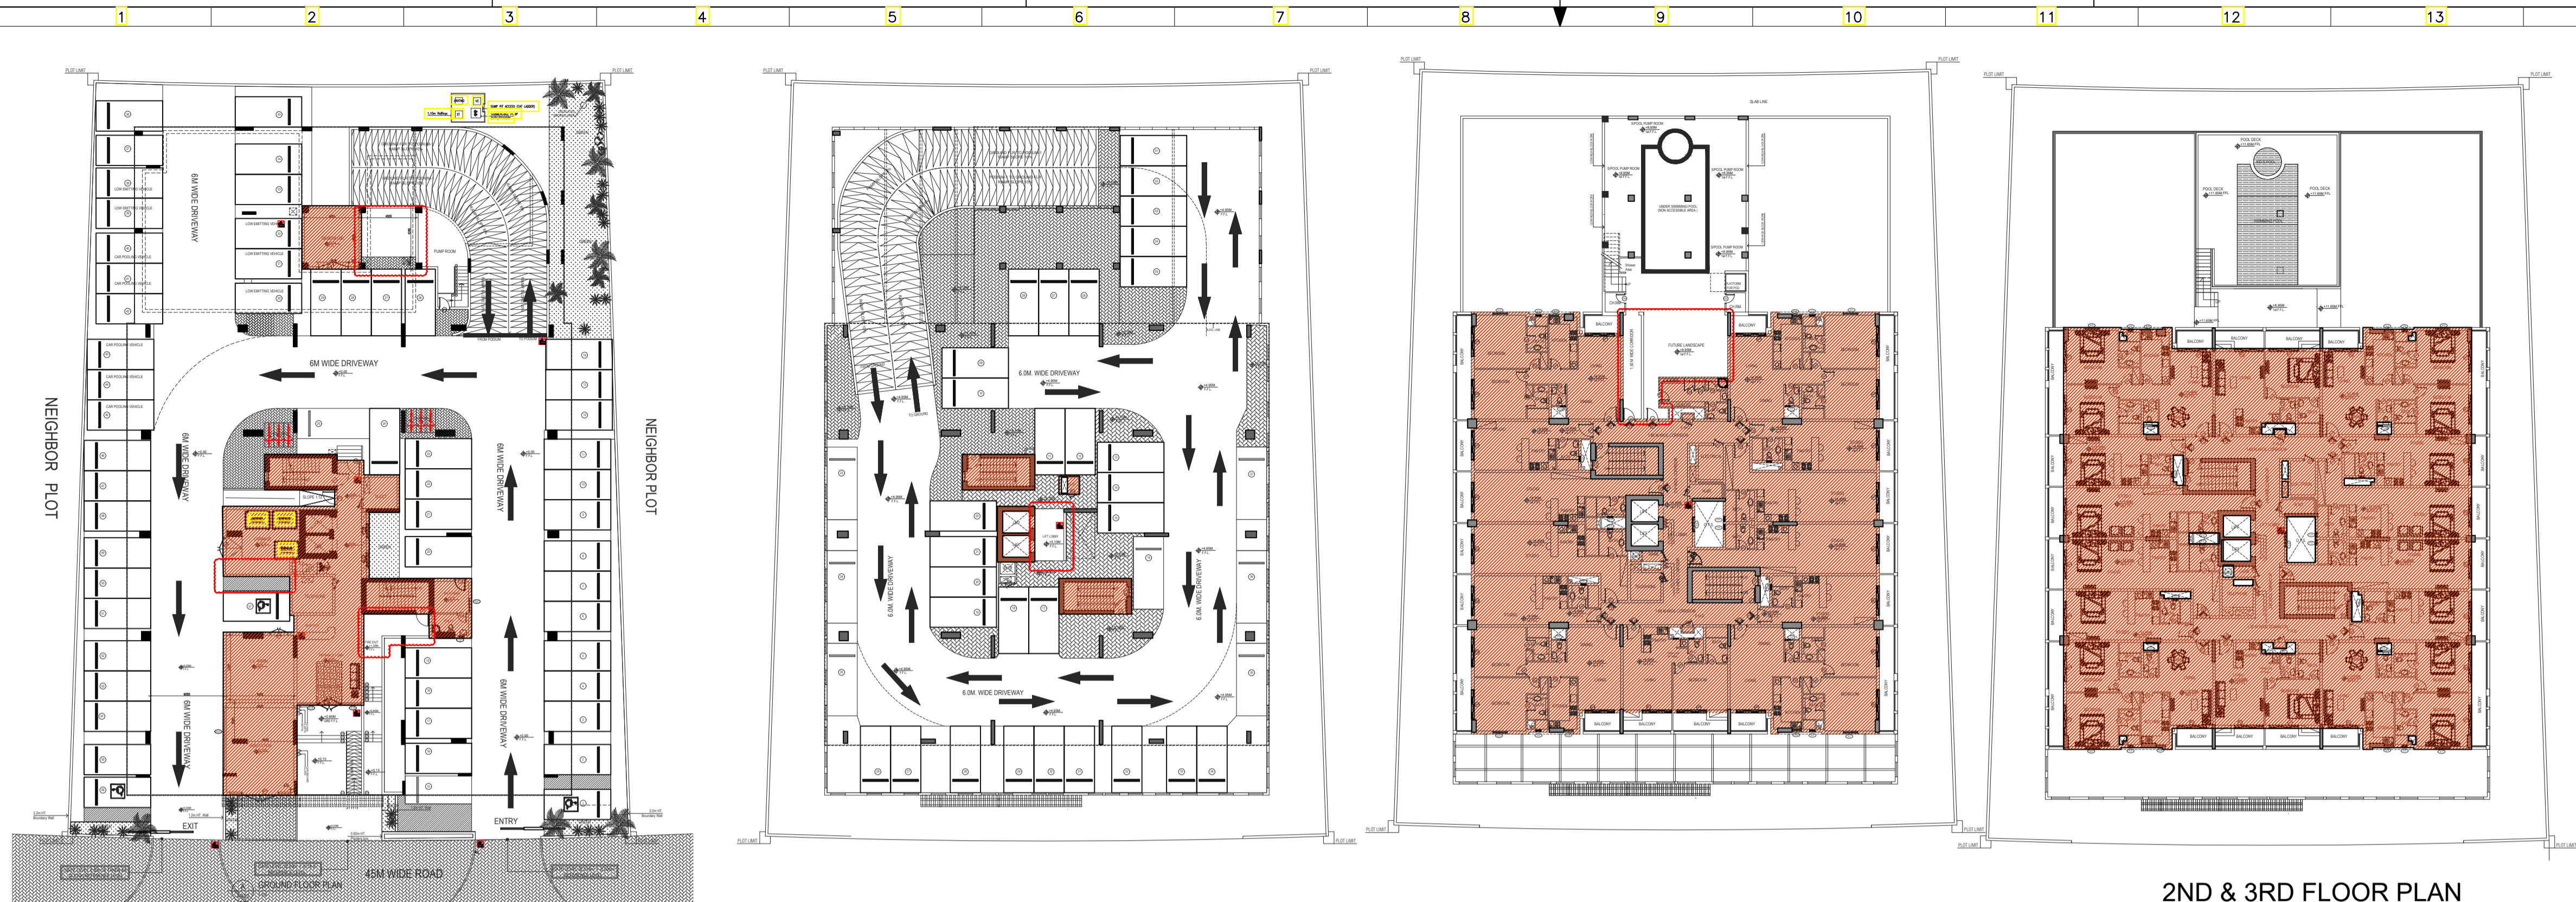

2ND & 3RD FLOOR PLAN

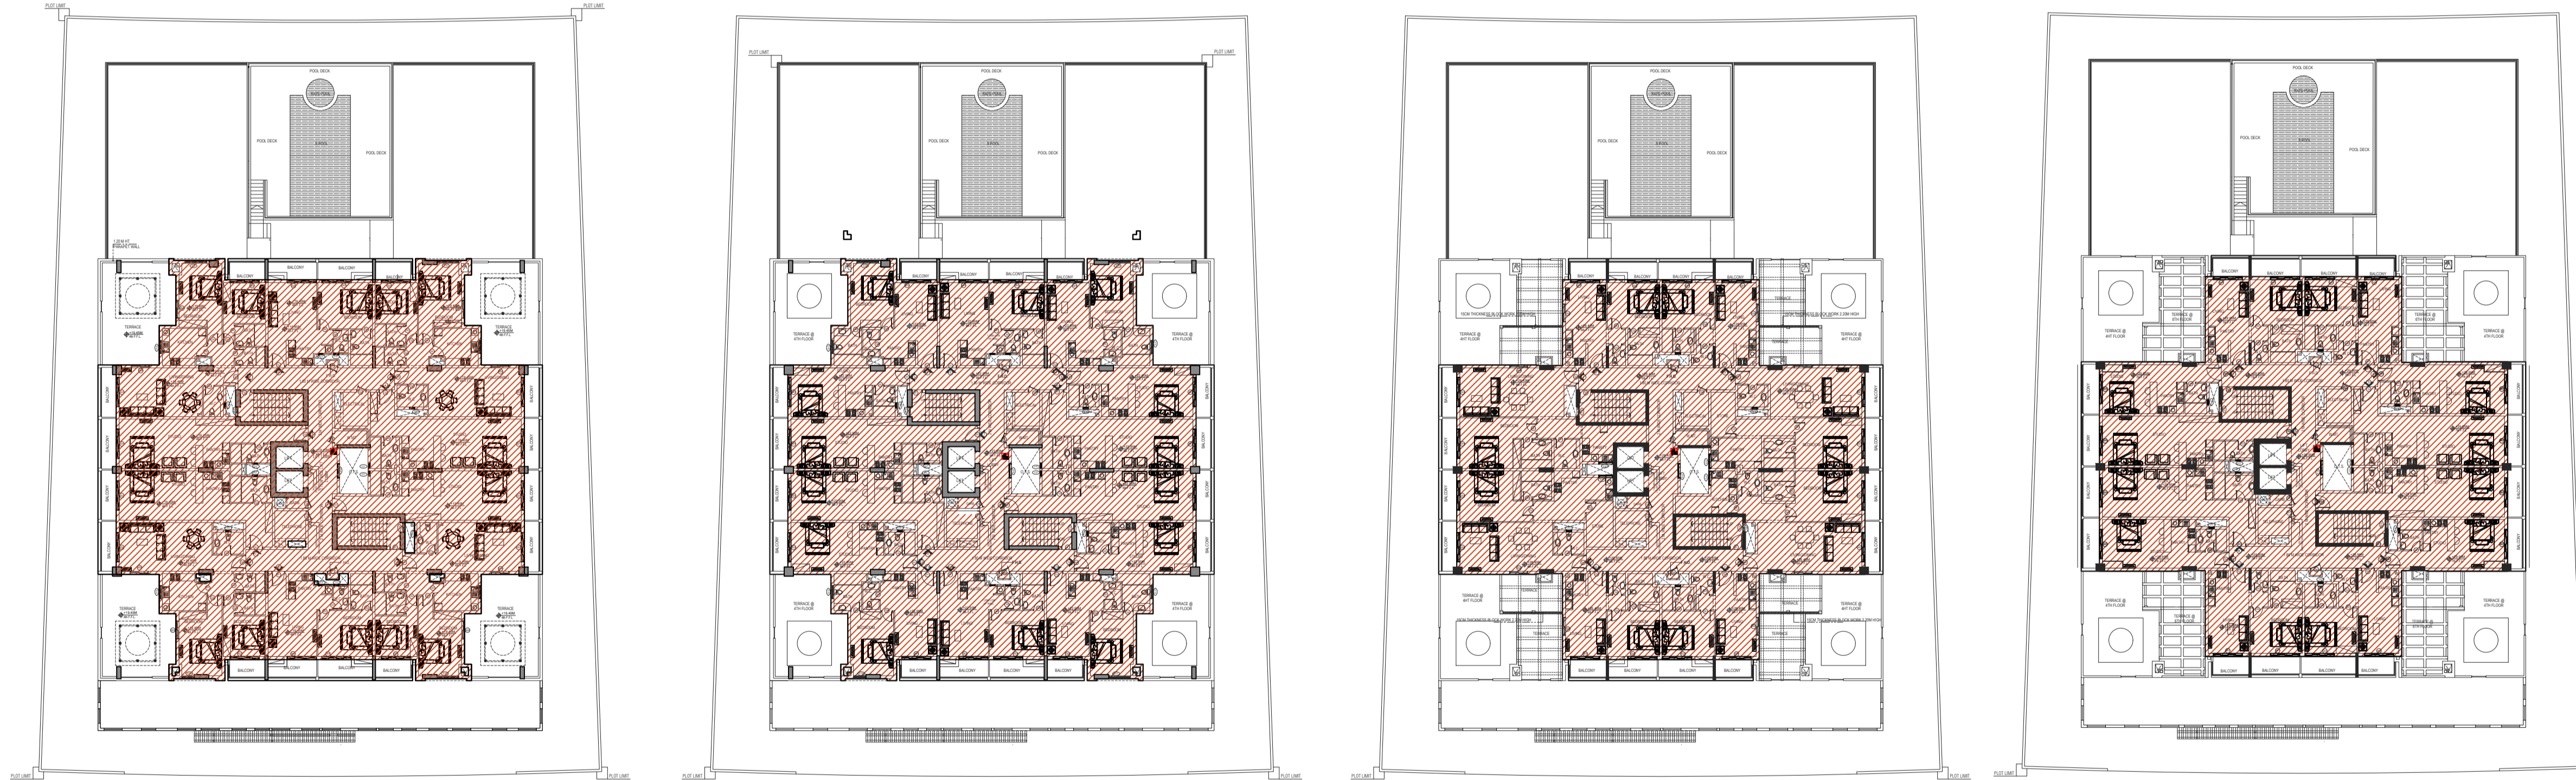


4TH FLOOR

5TH FLOOR

6TH FLOOR

7TH FLOOR

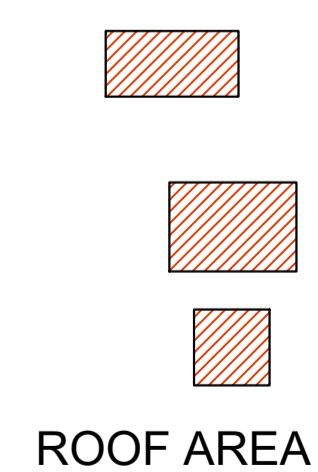

ROOF AREA

GROSS F.A.R. ALLOWED (2773.54x2.2)	=	6101.788 Sq.M
PLOT AREA	=	2773.54 Sq.M
TOTAL GROSS F.A.R. PROPOSED	=	7036.41 Sq.mts
F.A.R. CALCULATIONS		
LEVELS	NO. OF FLOORS	F.A.R. Sq.M
GROUND FLOOR LEVEL	1	307.85 Sq.mts
PODIUM FLOOR LEVEL	1	43.45 Sq.mts
1st FLOOR	1	1039.00 Sq.mts
2nd & 3rd FLOOR	2	(1084.02x2) = 2168.04 Sq.mts
4th & 5th FLOOR	2	(931.85x2) = 1863.70 Sq.mts
6th & 7th FLOOR	2	(781.23x2) = 1562.46 Sq.mts
ROOF	1	51.91 Sq.mts
TOTAL GROSS F.A.R. PROPOSED		7036.41 Sq.mts
SUMMARY OF ALLOWABLE F.A.R. & PROVIDED F.A.R.		
PLOT AREA	2773.54 SQ.MT	
ALLOWABLE F.A.R.	2773.54 X 2.2 = 6101.78 SQ.MT	
PROVIDED F.A.R.	7036.41 SQ.MT (2.537)	
DIFFERENCE IN AREA	(7036.41) - 6101.78 = (934.63 SQ.MT EXTRA F.A.R. PROVIDED)	

- GENERAL NOTES
1. THIS DRAWING IS THE PROPERTY OF :
na architects engineering consultancy
P.O.Box 237347, DUBAI.
IT IS FORBIDDEN TO PRODUCE IT'S CONTENTS IN ANY FORM, EXCEPT FOR THE INTENDED PURPOSE.
 2. THIS DRAWING IS NOT TO BE SCALED. THE STATED DIMENSIONS ONLY ARE TO BE CONSIDERED.
 3. THE DISCREPANCIES ARE TO BE BROUGHT TO THE ATTENTION AND RESOLVED BY NA ARCHITECTS ENGINEERING CONSULTANCY BEFORE COMMENCEMENT OF ANY WORK.
 4. ALWAYS FOLLOWED WRITTEN DIMENSION.

LEGEND

KEY PLAN

AS REVISED

CONTRACTORS REPRESENTATIVES	DATE	INITIALS
CM / PROJECT ENGINEER		
ARCHITECT		
STRUCTURAL ENGINEER		
SUBCONTRACTORS REPRESENTATIVES	DATE	INITIALS
MEP. COORDINATOR		
MECHANICAL ENGINEER		
ELECTRICAL ENGINEER		

PROJECT: RESIDENTIAL BUILDING G+1P+7+ROOF

REVIEW STATUS: A B C D

DATE REVIEWED: _____

REVIEWED BY: _____

DATE: _____

Rev	Date	Description	Drawn	Checked
AB	05/11/2019	AS BUILT DRAWING SUBMISSION	RCF	Engr. Hazem
AB	02/11/2019	AS BUILT DRAWING SUBMISSION	RCF	Engr. Hazem

CLIENT: MR. MASOOD ABDULLA MOHD ABDULAZIZ AL ZAROONI

LOCATION: IC- PHASE 3 PLOT No. IC3-H-40

PRINCIPAL CONSULTANT: NA ARCHITECTS ENGINEERING CONSULTANCY

MAIN CONTRACTOR: M C ALMABNA CONTRACTING COMPANY

SUB CONTRACTOR: M C ALMABNA CONTRACTING COMPANY


DRAWING TITLE: PARKING & GAR. CALCULATION-4

DRAWN BY: RCF JOB NO: P-10 DATE: 05.11.2019

CHECKED BY: Engr. Hazem SCALE: 1:100 SHEET SIZE: A1

PROJECT NO: NA/IC/B103 NA/IC/B103/15 SHOP DRAWING NO: REV: AB



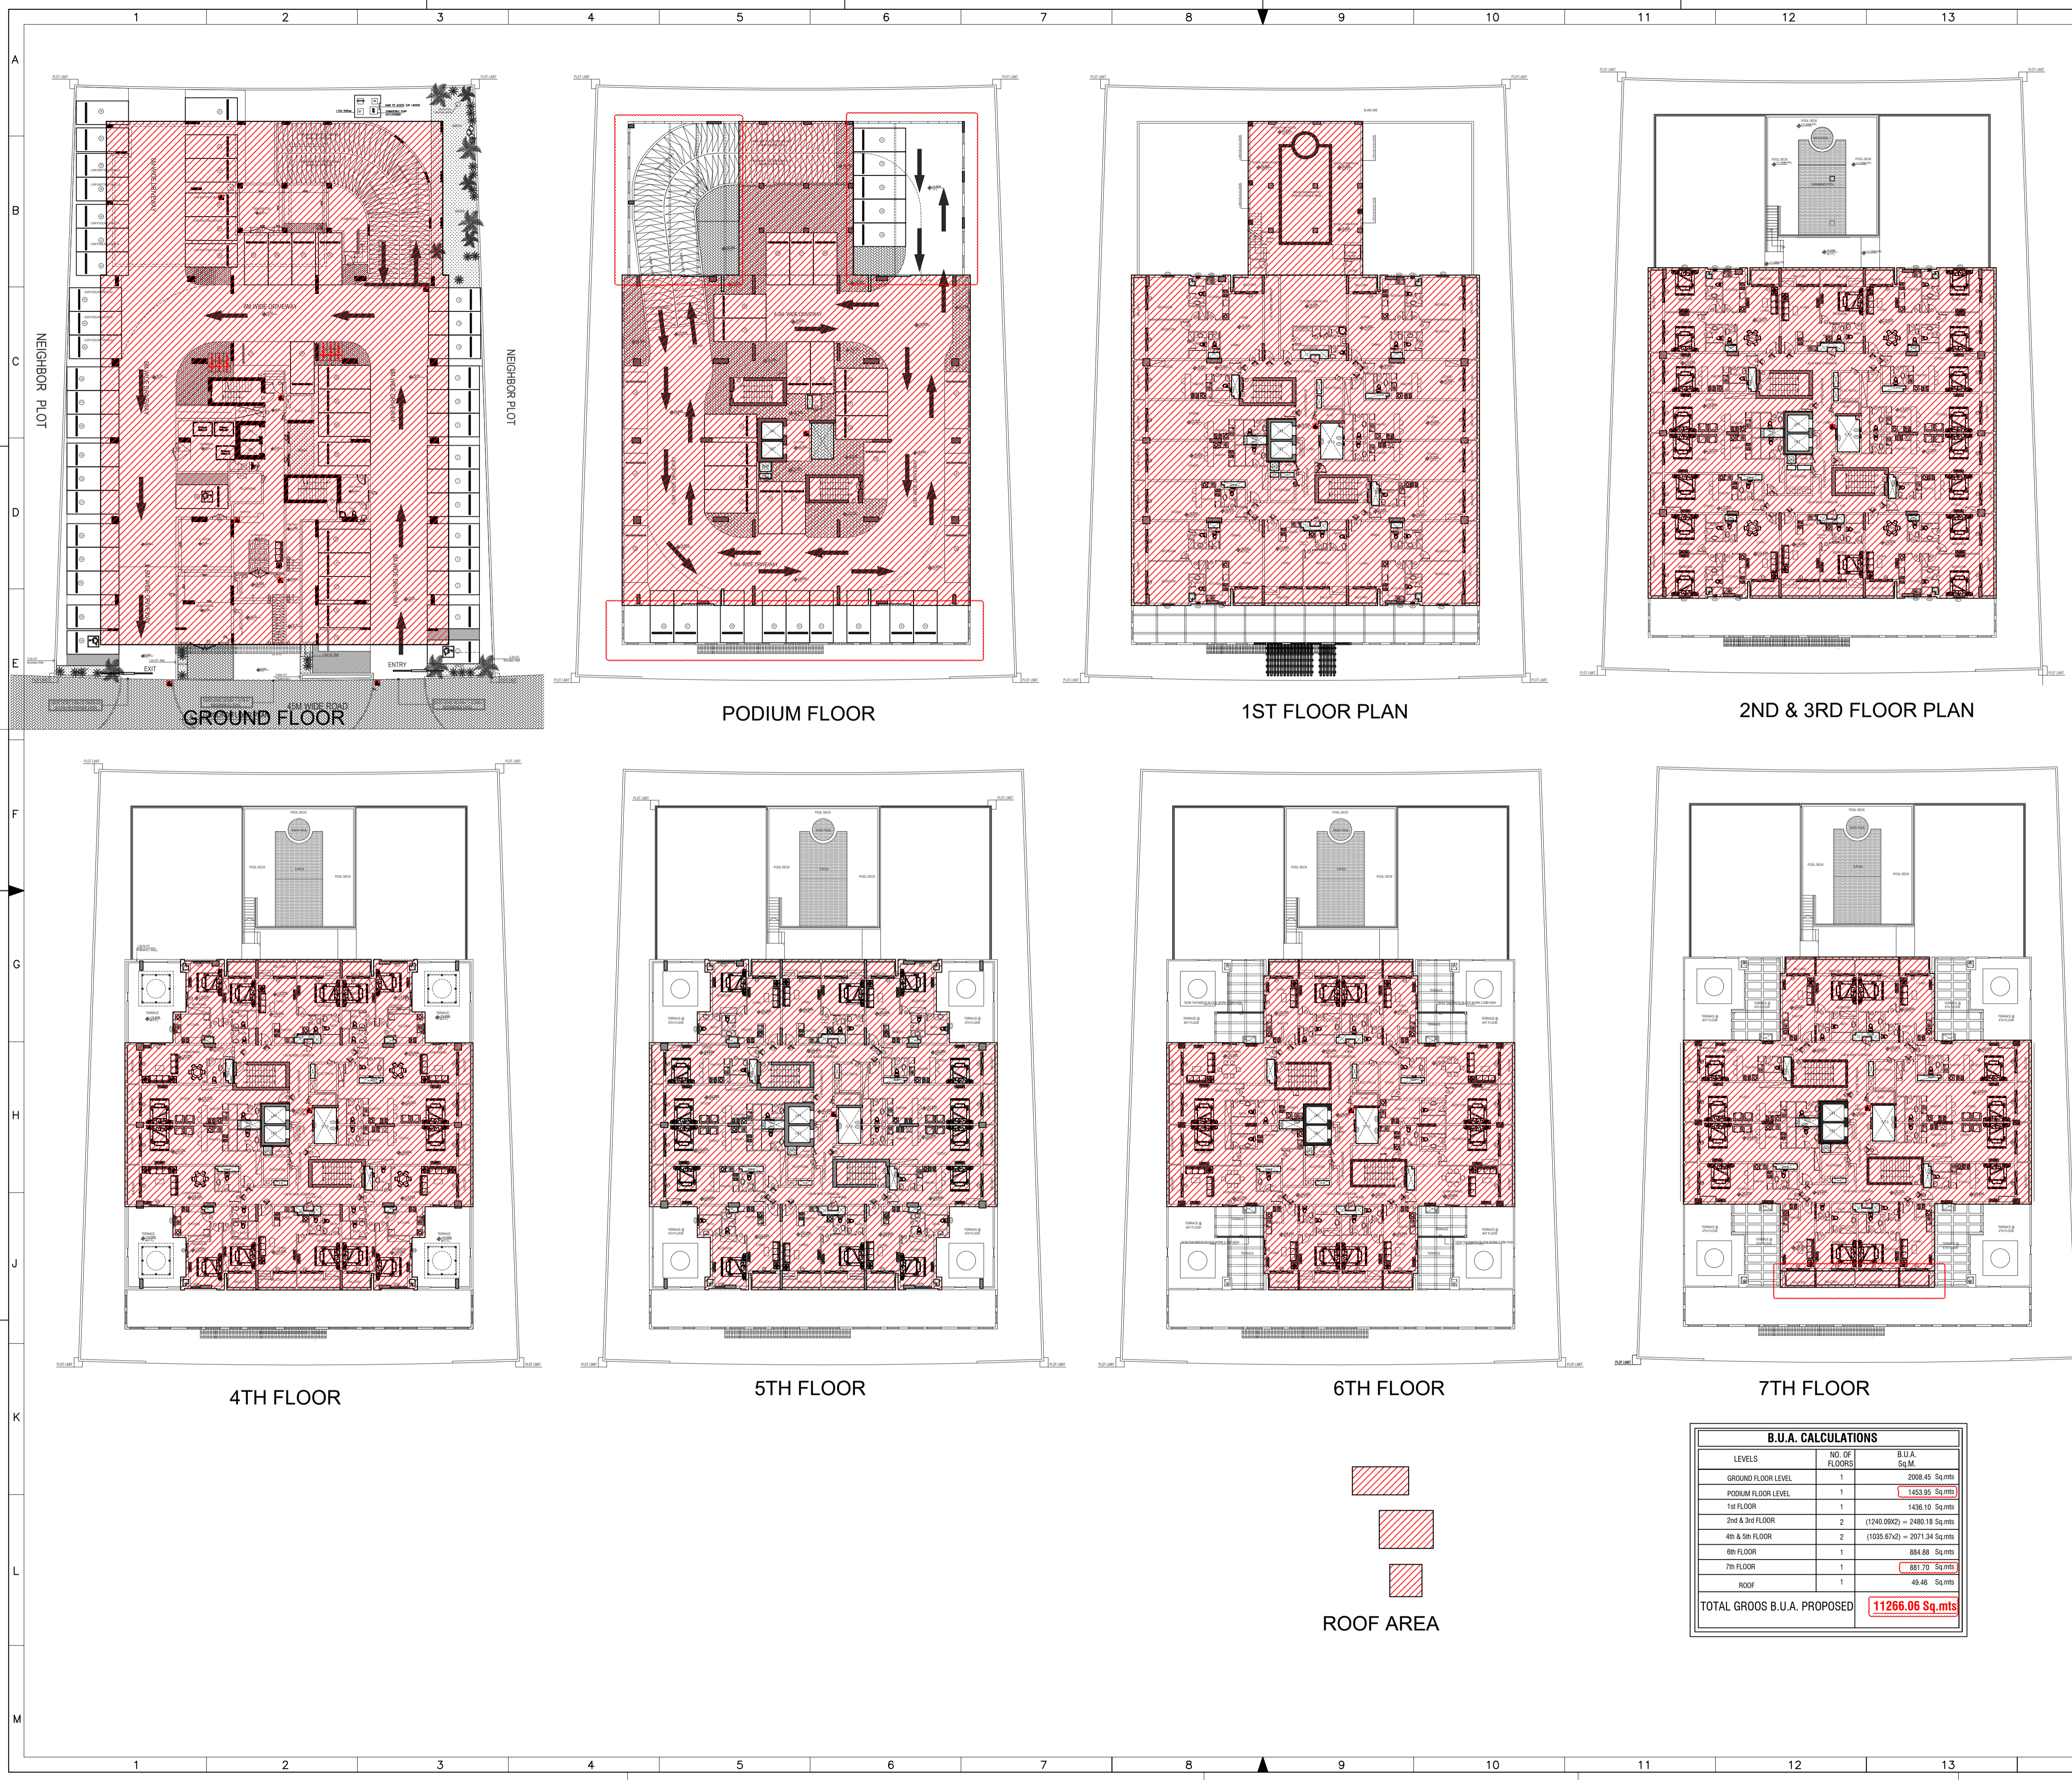

GENERAL NOTES

- THIS DRAWING IS THE PROPERTY OF: na architects engineering consultancy P.O.Box 237347, DUBAI. IT IS FORBIDDEN TO PRODUCE IT'S CONTENTS IN ANY FORM, EXCEPT FOR THE INTENDED PURPOSE.
- THIS DRAWING IS NOT TO BE SCALED. THE STATED DIMENSIONS ONLY ARE TO BE CONSIDERED.
- THE DISCREPANCIES ARE TO BE BROUGHT TO THE ATTENTION AND RESOLVED BY NA ARCHITECTS ENGINEERING CONSULTANCY BEFORE COMMENCEMENT OF ANY WORK.
- ALWAYS FOLLOWED WRITTEN DIMENSION.

LEGEND

KEY PLAN

AS REVISED

CONTRACTORS REPRESENTATIVES	DATE	INITIALS
CM / PROJECT ENGINEER		
ARCHITECT		
STRUCTURAL ENGINEER		
SUBCONTRACTORS REPRESENTATIVES	DATE	INITIALS
MEP. COORDINATOR		
MECHANICAL ENGINEER		
ELECTRICAL ENGINEER		

PROJECT:
RESIDENTIAL BUILDING
G+1P+7+ROOF

REVIEW STATUS: A B C D

DATE REVIEWED: _____

REVIEWED BY: _____

DATE: _____

Rev	Date	Description	Drawn	Checked
AB	05/11/2019	AS BUILT DRAWING SUBMISSION	RCF	Engr. Hazem
AB	02/11/2019	AS BUILT DRAWING SUBMISSION	RCF	Engr. Hazem

CLIENT:
MR. MASOOD ABDULLA MOHD
ABDULAZIZ AL ZAROONI

LOCATION: IC- PHASE 3 **PLOT No.:** IC3-H-40

PRINCIPAL CONSULTANT:
NA ARCHITECTS ENGINEERING CONSULTANCY
OFFICE 2601 - THE EXCHANGE TOWER
BUSINESS BAY - DUBAI - U.A.E
TEL: 04-2777820 P.O.BOX: 237347
www.naarchitects.net

MAIN CONTRACTOR:
MC ALMABNA CONTRACTING COMPANY

SUB CONTRACTOR:
MC ALMABNA CONTRACTING COMPANY

DRAWING TITLE:
BUILT UP AREA CALCULATION

DRAWN BY: RCF **JOB NO.:** P-10 **DATE:** 05.11.2019

CHECKED BY: Engr. Hazem **SCALE:** 1:100 **SHEET SIZE:** A1

PROJECT NO.: NA/IC/B103 **SHOP DRAWING NO.:** **REV:** AB

B.U.A. CALCULATIONS		
LEVELS	NO. OF FLOORS	B.U.A. Sq.M.
GROUND FLOOR LEVEL	1	2008.45 Sq.mts
PODIUM FLOOR LEVEL	1	1433.85 Sq.mts
1st FLOOR	1	1436.10 Sq.mts
2nd & 3rd FLOOR	2	(1240.09x2) = 2480.18 Sq.mts
4th & 5th FLOOR	2	(1035.67x2) = 2071.34 Sq.mts
6th FLOOR	1	884.88 Sq.mts
7th FLOOR	1	881.79 Sq.mts
ROOF	1	49.46 Sq.mts
TOTAL GROSS B.U.A. PROPOSED:		11266.06 Sq.mts

ROOF AREA

FLATS SCHEDULE			
LEVELS	2BEDROOM	1BEDROOM	STUDIO
1st FLOOR	4 no's	1 no.	8 no's
2nd FLOOR	4 no's	2 no's	8 no's
3rd FLOOR	4 no's	2 no's	8 no's
4th FLOOR	4 no's	2 no's	4 no's
5th FLOOR	-----	6 no's	8 no's
6th FLOOR	-----	8 no's	-----
7th FLOOR	-----	4 no's	8 no's
TOTAL FLATS PROVIDED	16 no's	25 no's	44 no's

TOTAL NO. OF FLATS - 85

PARKING CALCULATIONS-REQUIRED			
UNIT TYPE	TOTAL UNIT	REQUATIONS	TOTAL
2 BED ROOM	16 NOS.	UNIT/1.5 PARKING	24 NOS.
1 BED ROOM	25 NOS.	UNIT/1 PARKING	25 NOS.
STUDIO'S	44 NOS.	UNIT/1 PARKING	44 NOS.
VISITOR'S	FOR 35 CARS=1 PARKING		03 NOS.
TOTAL			96 NOS.

PARKING CALCULATIONS-PROVIDED	
FLOORS	NUMBERS
GROUND	57 NOS
PODIUM	37 NOS
TOTAL	94 NOS. PARKING

POD PARKING 3% = $94 \times 3 / 100 = 3.00$ NOS(REQUIRED) - 3.00 NOS (PROVIDED)

FLATS AREA / FLOOR	
LEVELS	AREA IN SQ.M
1st FLOOR	804.12
2nd FLOOR	860.29
3rd FLOOR	860.29
4th FLOOR	717.93
5th FLOOR	711.23
6th FLOOR	717.93
7th FLOOR	573.14
TOTAL FLATS AREA	5244.93 SQ.M 56456.42 SQ.FT

SUMMARY FOR GARBAGE CONTAINER			
CALCULATIONS	WEIGHT	NO. OF CONT. REQ.	NO. OF CONT. PROVIDED
(TOTAL COMMERCIAL AREA = / 1000) x12 KG =	NIL		3 No's OF CONTAINER 2.5 CUB. M SIZE
(TOTAL SHOPPING AREA = /1000)x12 KG =	NIL		
(TOTAL RESIDENTIAL AREA = 56817.55 /1000) x 12 KG =	681.81 KG.	3 No's OF CONTAINER 2.5 CUB. M SIZE	
TOTAL WEIGHT	681.81 KG.		

- GENERAL NOTES
- THIS DRAWING IS THE PROPERTY OF :
na architects engineering consultancy
P.O.Box 237347, DUBAI
IT IS FORBIDDEN TO PRODUCE IT'S CONTENTS IN ANY FORM, EXCEPT FOR THE INTENDED PURPOSE.
 - THIS DRAWING IS NOT TO BE SCALED. THE STATED DIMENSIONS ONLY ARE TO BE CONSIDERED.
 - THE DISCREPANCIES ARE TO BE BROUGHT TO THE ATTENTION AND RESOLVED BY NA ARCHITECTS ENGINEERING CONSULTANCY BEFORE COMMENCEMENT OF ANY WORK.
 - ALWAYS FOLLOWED WRITTEN DIMENSION.

LEGEND

KEY PLAN

AS REVISED

CONTRACTORS REPRESENTATIVES	DATE	INITIALS
CM / PROJECT ENGINEER		
ARCHITECT		
STRUCTURAL ENGINEER		
SUBCONTRACTORS REPRESENTATIVES	DATE	INITIALS
MEP. COORDINATOR		
MECHANICAL ENGINEER		
ELECTRICAL ENGINEER		

PROJECT:
**RESIDENTIAL BUILDING
G+1P+7+ROOF**

REVIEW STATUS	<input type="checkbox"/> A	<input type="checkbox"/> B	<input type="checkbox"/> C	<input type="checkbox"/> D
DATE REVIEWED				
REVIEWED BY				
DATE:				

Rev	Date	Description	Drawn	Checked
AB	05/11/2019	AS BUILT DRAWING SUBMISSION	RCF	Engr. Hazem
AB	02/11/2019	AS BUILT DRAWING SUBMISSION	RCF	Engr. Hazem

CLIENT :
**MR. MASOOD ABDULLA MOHD
ABDULAZIZ AL ZAROONI**

LOCATION	PLOT No.
IC- PHASE 3	IC3-H-40

PRINCIPAL CONSULTANT:
NA ARCHITECTS ENGINEERING CONSULTANCY
OFFICE 2601 - THE EXCHANGE TOWER
BUSINESS BAY - DUBAI - U.A.E
TEL: 04-2777820 P.O.BOX- 237347
www.naarchitects.net

MAIN CONTRACTOR :
MC ALMABNA CONTRACTING COMPANY


SUB CONTRACTOR :
MC ALMABNA CONTRACTING COMPANY

DRAWING TITLE :
PARKING & GAR. CALCULATION-4

DRAWN BY:	JOB NO:	DATE:
RCF	P-10	05.11.2019

CHECKED BY:	SCALE:	SHEET SIZE:
Engr. Hazem	1:100	A1

PROJECT NO:	SHOP DRAWING NO:	REV:
NA/IC/B103 NA/IC/B103/15		AB

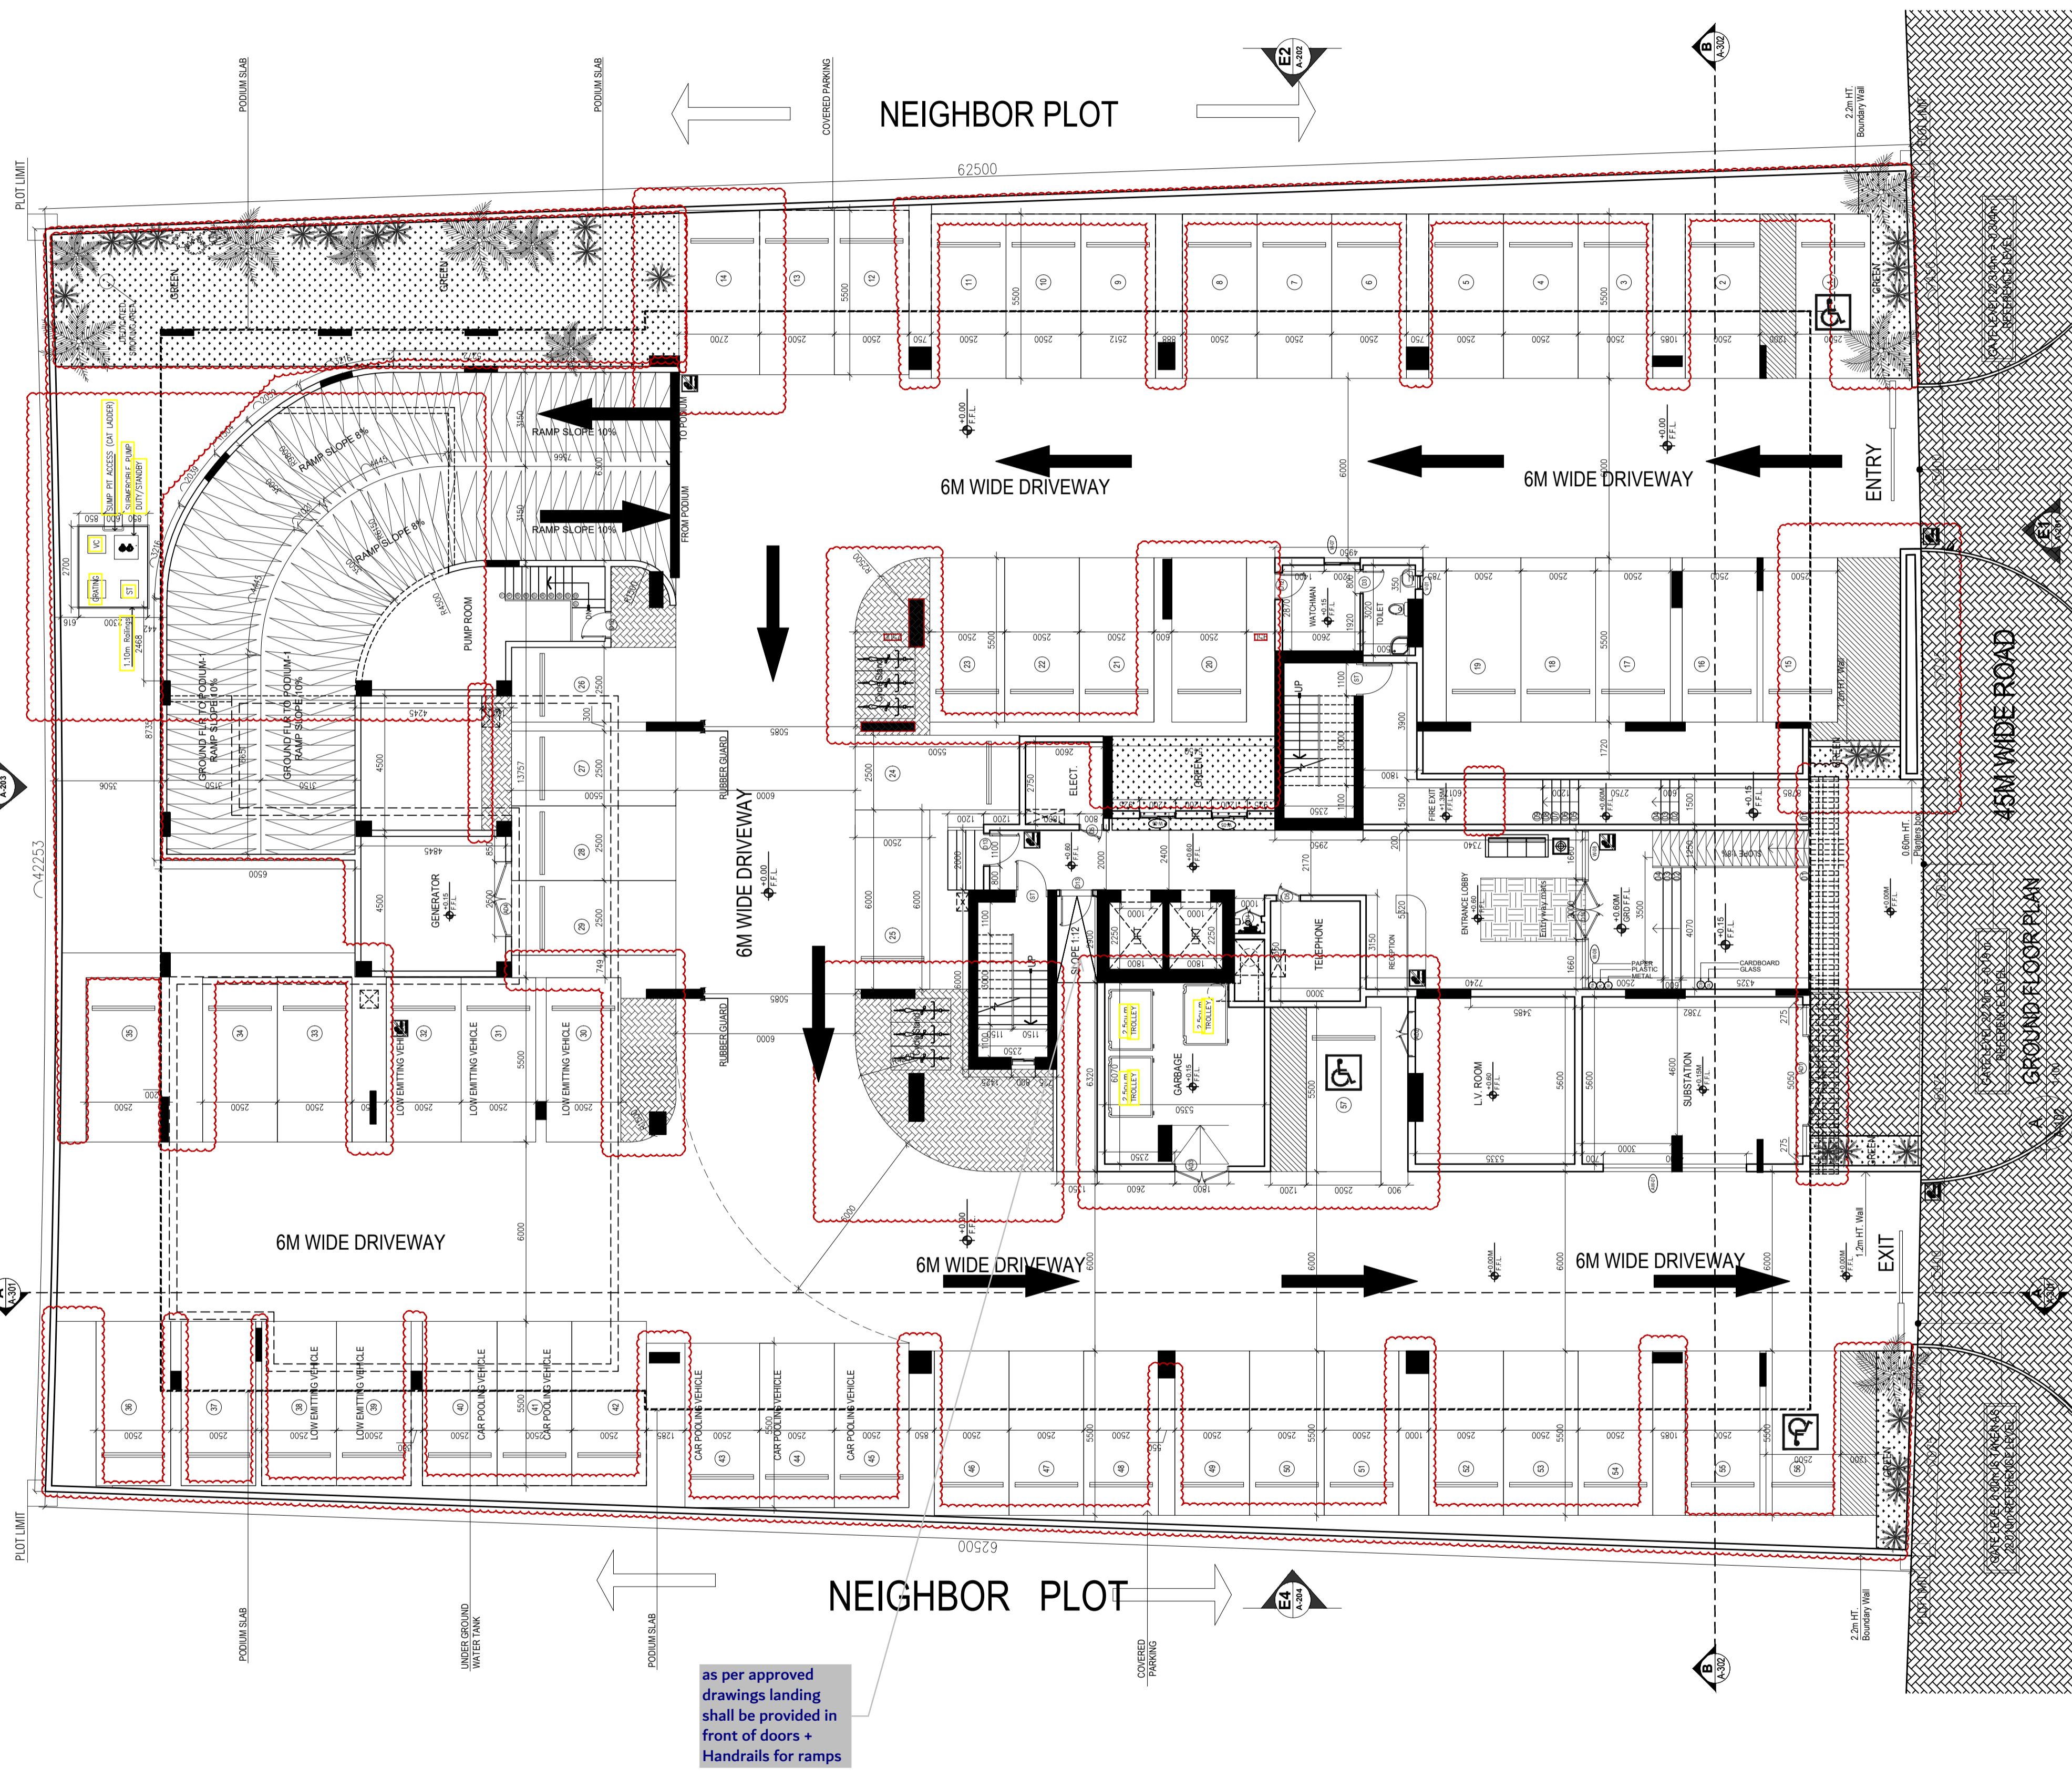

as per approved drawings landing shall be provided in front of doors + Handrails for ramps

- GENERAL NOTES**
1. THIS DRAWING IS THE PROPERTY OF : na architects engineering consultancy P.O.Box 237347, DUBAI. IT IS FORBIDDEN TO PRODUCE ITS CONTENTS IN ANY FORM, EXCEPT FOR THE INTENDED PURPOSE.
 2. THIS DRAWING IS NOT TO BE SCALED. THE STATED DIMENSIONS ONLY ARE TO BE CONSIDERED.
 3. THE DISCREPANCIES ARE TO BE BROUGHT TO THE ATTENTION AND RESOLVED BY NA ARCHITECTS ENGINEERING CONSULTANCY BEFORE COMMENCEMENT OF ANY WORK.
 4. ALWAYS FOLLOWED WRITTEN DIMENSION.

- LEGEND**
- KEY PLAN**
- NO SMOKING
 - BIN FOR PAPER
 - BIN FOR PLASTIC
 - BIN FOR METAL
 - BIN FOR CARDBOARD
 - BIN FOR GLASS

AS BUILT

CONTRACTORS REPRESENTATIVES	DATE	INITIALS
CM / PROJECT ENGINEER		
ARCHITECT		
STRUCTURAL ENGINEER		

SUBCONTRACTORS REPRESENTATIVES	DATE	INITIALS
MEP. COORDINATOR		
MECHANICAL ENGINEER		
ELECTRICAL ENGINEER		

PROJECT:

**RESIDENTIAL BUILDING
G+1P+7+ROOF**

REVIEW STATUS A B C D

DATE REVIEWED

REVIEWED BY

PREVIOUS DTF NO. MC/P10/DTF/020-01 **DATE:**

Rev	Date	Description	Drawn	Checked
AB	05/11/2019	AS BUILT DRAWING SUBMISSION	RCF	Engr. Hazem
AB	02/11/2019	AS BUILT DRAWING SUBMISSION	RCF	Engr. Hazem

CLIENT:

**MR. MASOOD ABDULLA MOHD
ABDULAZIZ AL ZAROONI**

LOCATION **PLOT No.**

IC- PHASE 3 IC3-H-40

PRINCIPAL CONSULTANT:

ان ايه ار كينكتس للاستشارات الهندسية
NA ARCHITECTS ENGINEERING CONSULTANCY

OFFICE 2001 - THE BICHANE TOWER
BUSINESS BAY - DUBAI - U.A.E
TEL: 04-2777620 P.O.BOX: 237347
WWW.NAARCHITECTS.COM

MAIN CONTRACTOR:

ALMABNA CONTRACTING COMPANY

Dubai - A.E.
Tel: 04-3611111
P.O.Box: 233146

SUB CONTRACTOR:

ALMABNA CONTRACTING COMPANY

Dubai - A.E.
Tel: 04-3611111
P.O.Box: 233146


DRAWING TITLE:

GROUND FLOOR PLAN

DRAWN BY: RCF	JOB NO.: P-10	DATE: 05.11.2019
CHECKED BY: Engr. Hazem	SCALE: 1:100	SHEET SIZE: A1
PROJECT NO.: NA/IC/B103 NA/IC/B103/15	SHOP DRAWING NO.:	REV.: AB

AS BUILT

NO OF PARKING SLOTS -56.00

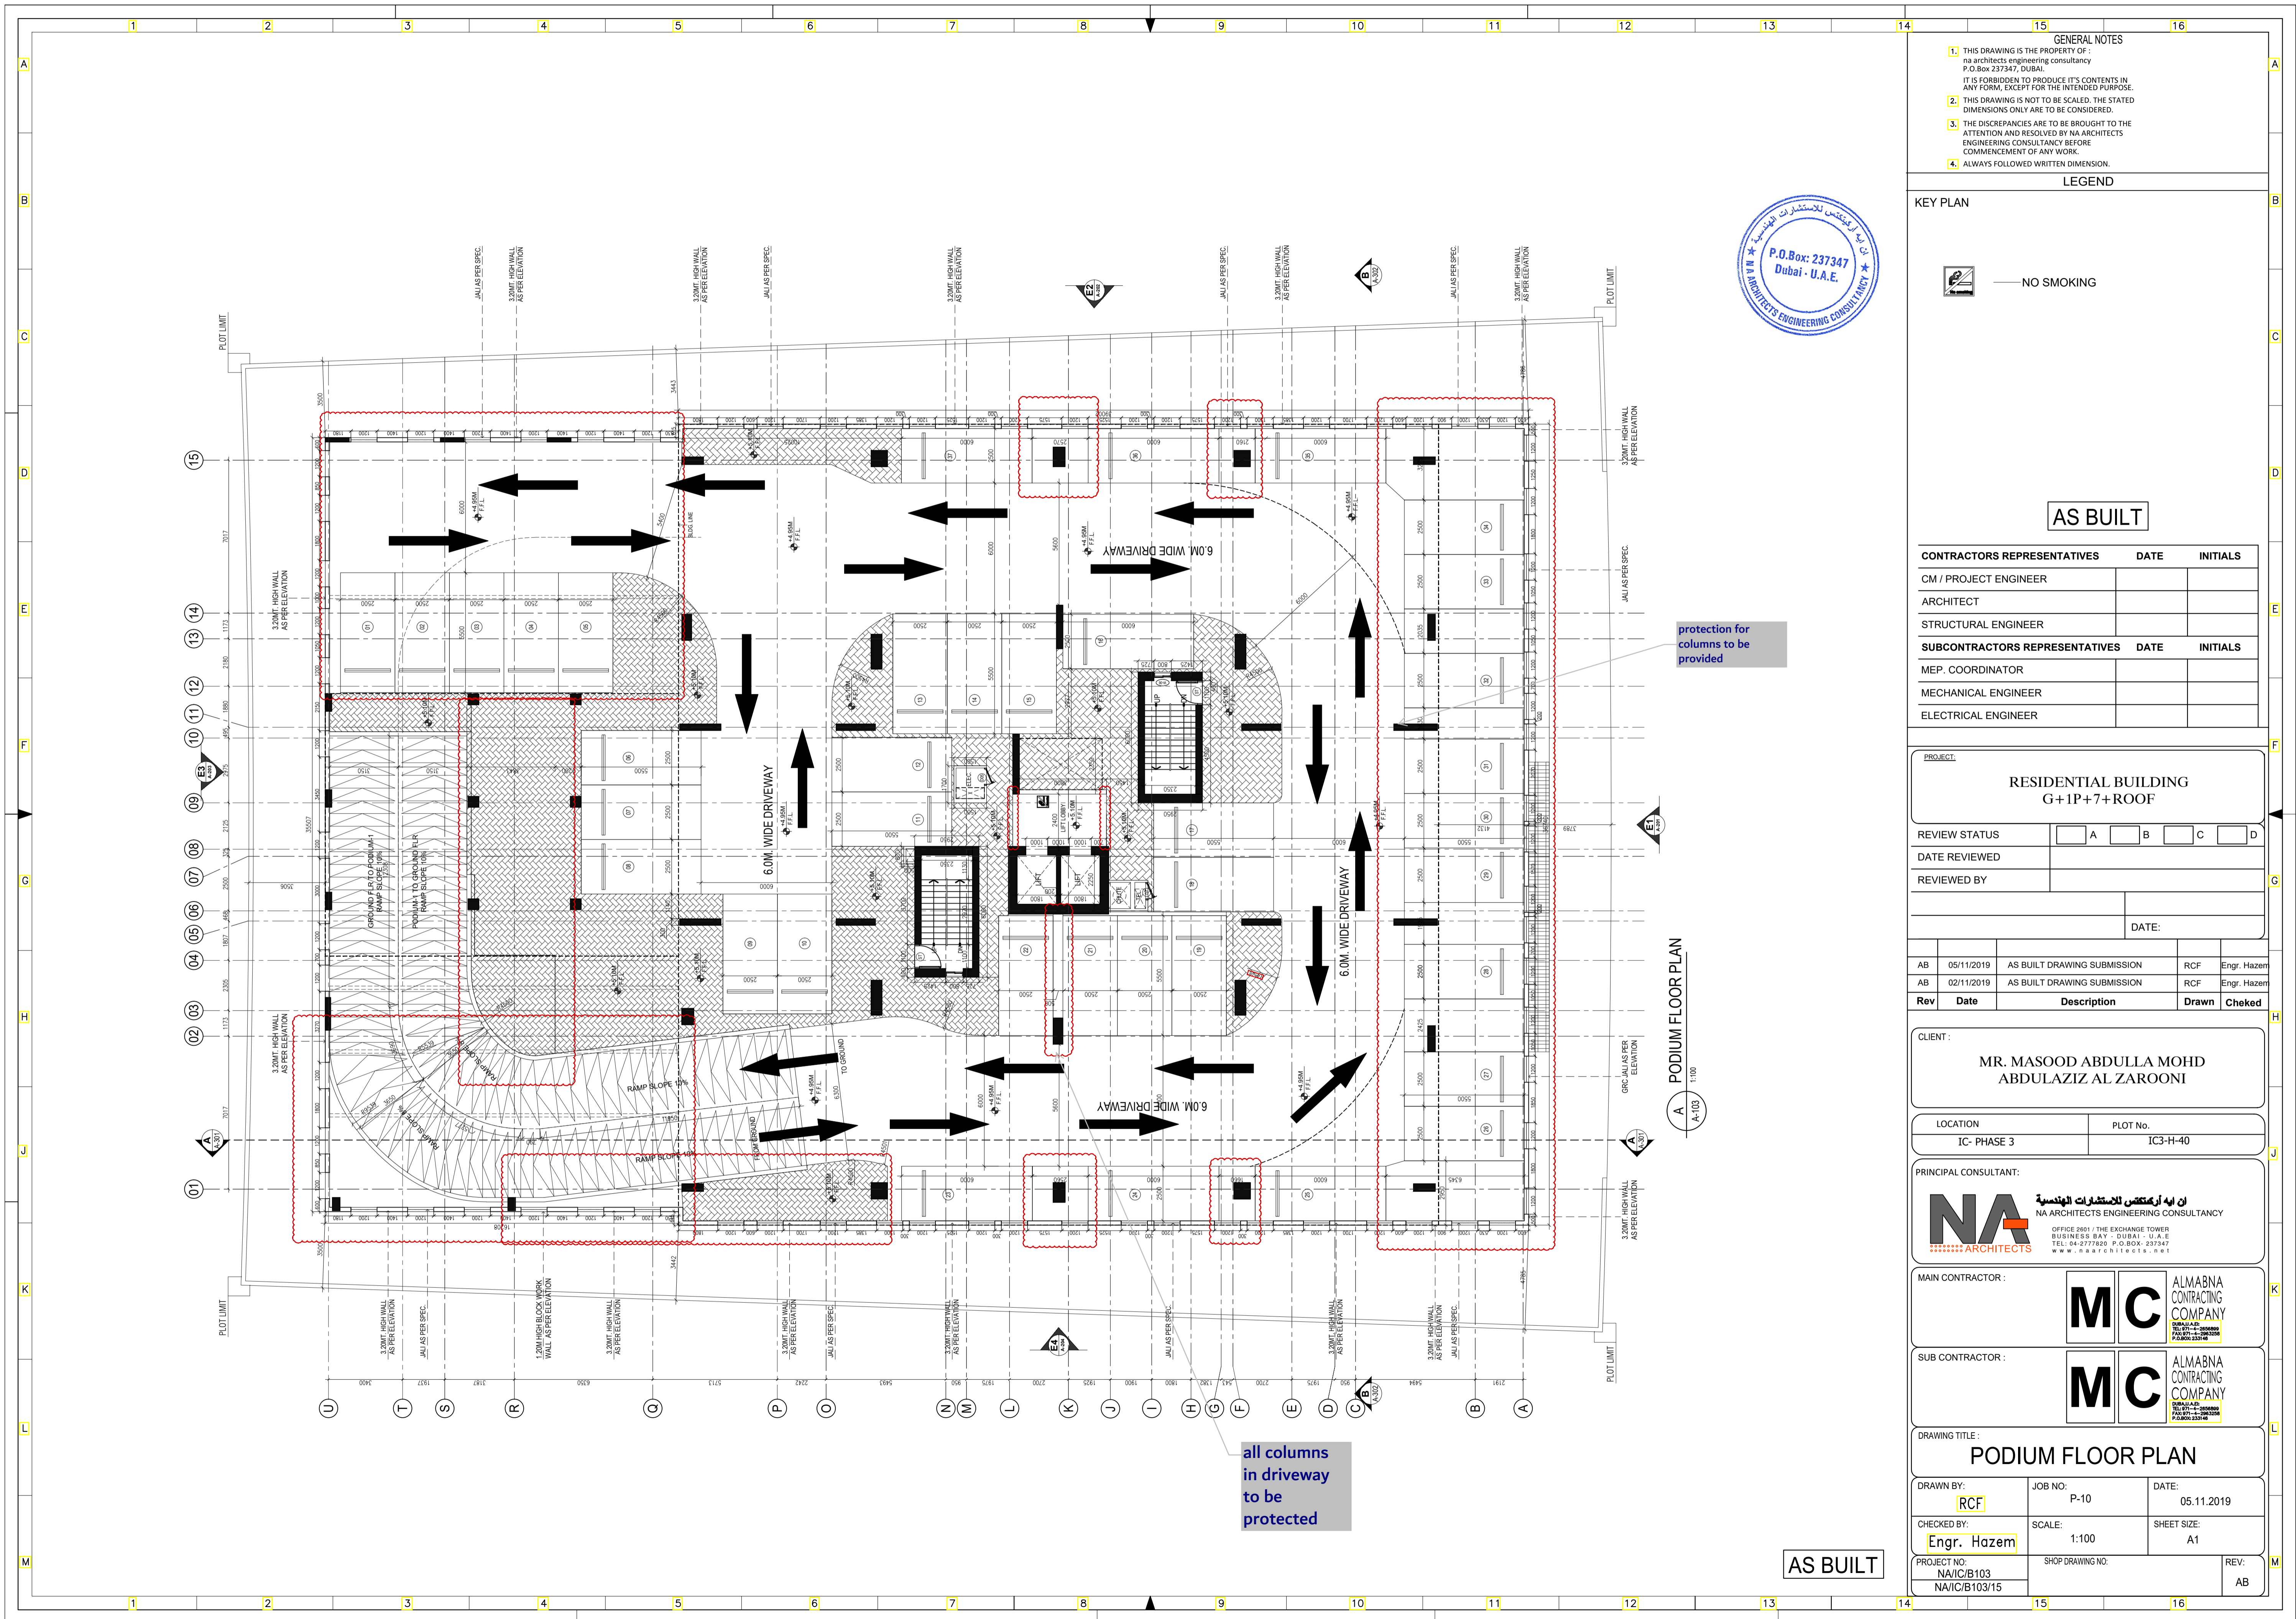

GENERAL NOTES

- THIS DRAWING IS THE PROPERTY OF :
na architects engineering consultancy
P.O.Box 237347, DUBAI.
IT IS FORBIDDEN TO PRODUCE ITS CONTENTS IN ANY FORM, EXCEPT FOR THE INTENDED PURPOSE.
- THIS DRAWING IS NOT TO BE SCALED. THE STATED DIMENSIONS ONLY ARE TO BE CONSIDERED.
- THE DISCREPANCIES ARE TO BE BROUGHT TO THE ATTENTION AND RESOLVED BY NA ARCHITECTS ENGINEERING CONSULTANCY BEFORE COMMENCEMENT OF ANY WORK.
- ALWAYS FOLLOWED WRITTEN DIMENSION.

LEGEND

KEY PLAN

NO SMOKING

AS BUILT

CONTRACTORS REPRESENTATIVES	DATE	INITIALS
CM / PROJECT ENGINEER		
ARCHITECT		
STRUCTURAL ENGINEER		

SUBCONTRACTORS REPRESENTATIVES	DATE	INITIALS
MEP. COORDINATOR		
MECHANICAL ENGINEER		
ELECTRICAL ENGINEER		

PROJECT:

**RESIDENTIAL BUILDING
G+1P+7+ROOF**

REVIEW STATUS: A B C D

DATE REVIEWED: _____

REVIEWED BY: _____

DATE: _____

Rev	Date	Description	Drawn	Checked
AB	05/11/2019	AS BUILT DRAWING SUBMISSION	RCF	Engr. Hazem
AB	02/11/2019	AS BUILT DRAWING SUBMISSION	RCF	Engr. Hazem

CLIENT:

**MR. MASOOD ABDULLA MOHD
ABDULAZIZ AL ZAROONI**

LOCATION: IC- PHASE 3 PLOT No. IC3-H-40

PRINCIPAL CONSULTANT:

NA ARCHITECTS
 ان ايه آر اركيكتس للاستشارات الهندسية
 NA ARCHITECTS ENGINEERING CONSULTANCY
 OFFICE 2601, THE EXCHANGE TOWER
 BUSINESS BAY - DUBAI - U.A.E
 TEL: 04-2777828 P.O.BOX: 237347
 www.naarchitects.net

MAIN CONTRACTOR:

MC ALMABNA CONTRACTING COMPANY

SUB CONTRACTOR:

MC ALMABNA CONTRACTING COMPANY

DRAWING TITLE:


PODIUM FLOOR PLAN

DRAWN BY: **RCF** JOB NO: P-10 DATE: 05.11.2019

CHECKED BY: **Engr. Hazem** SCALE: 1:100 SHEET SIZE: A1

PROJECT NO: NA/IC/B103 SHOP DRAWING NO: REV: AB

AS BUILT

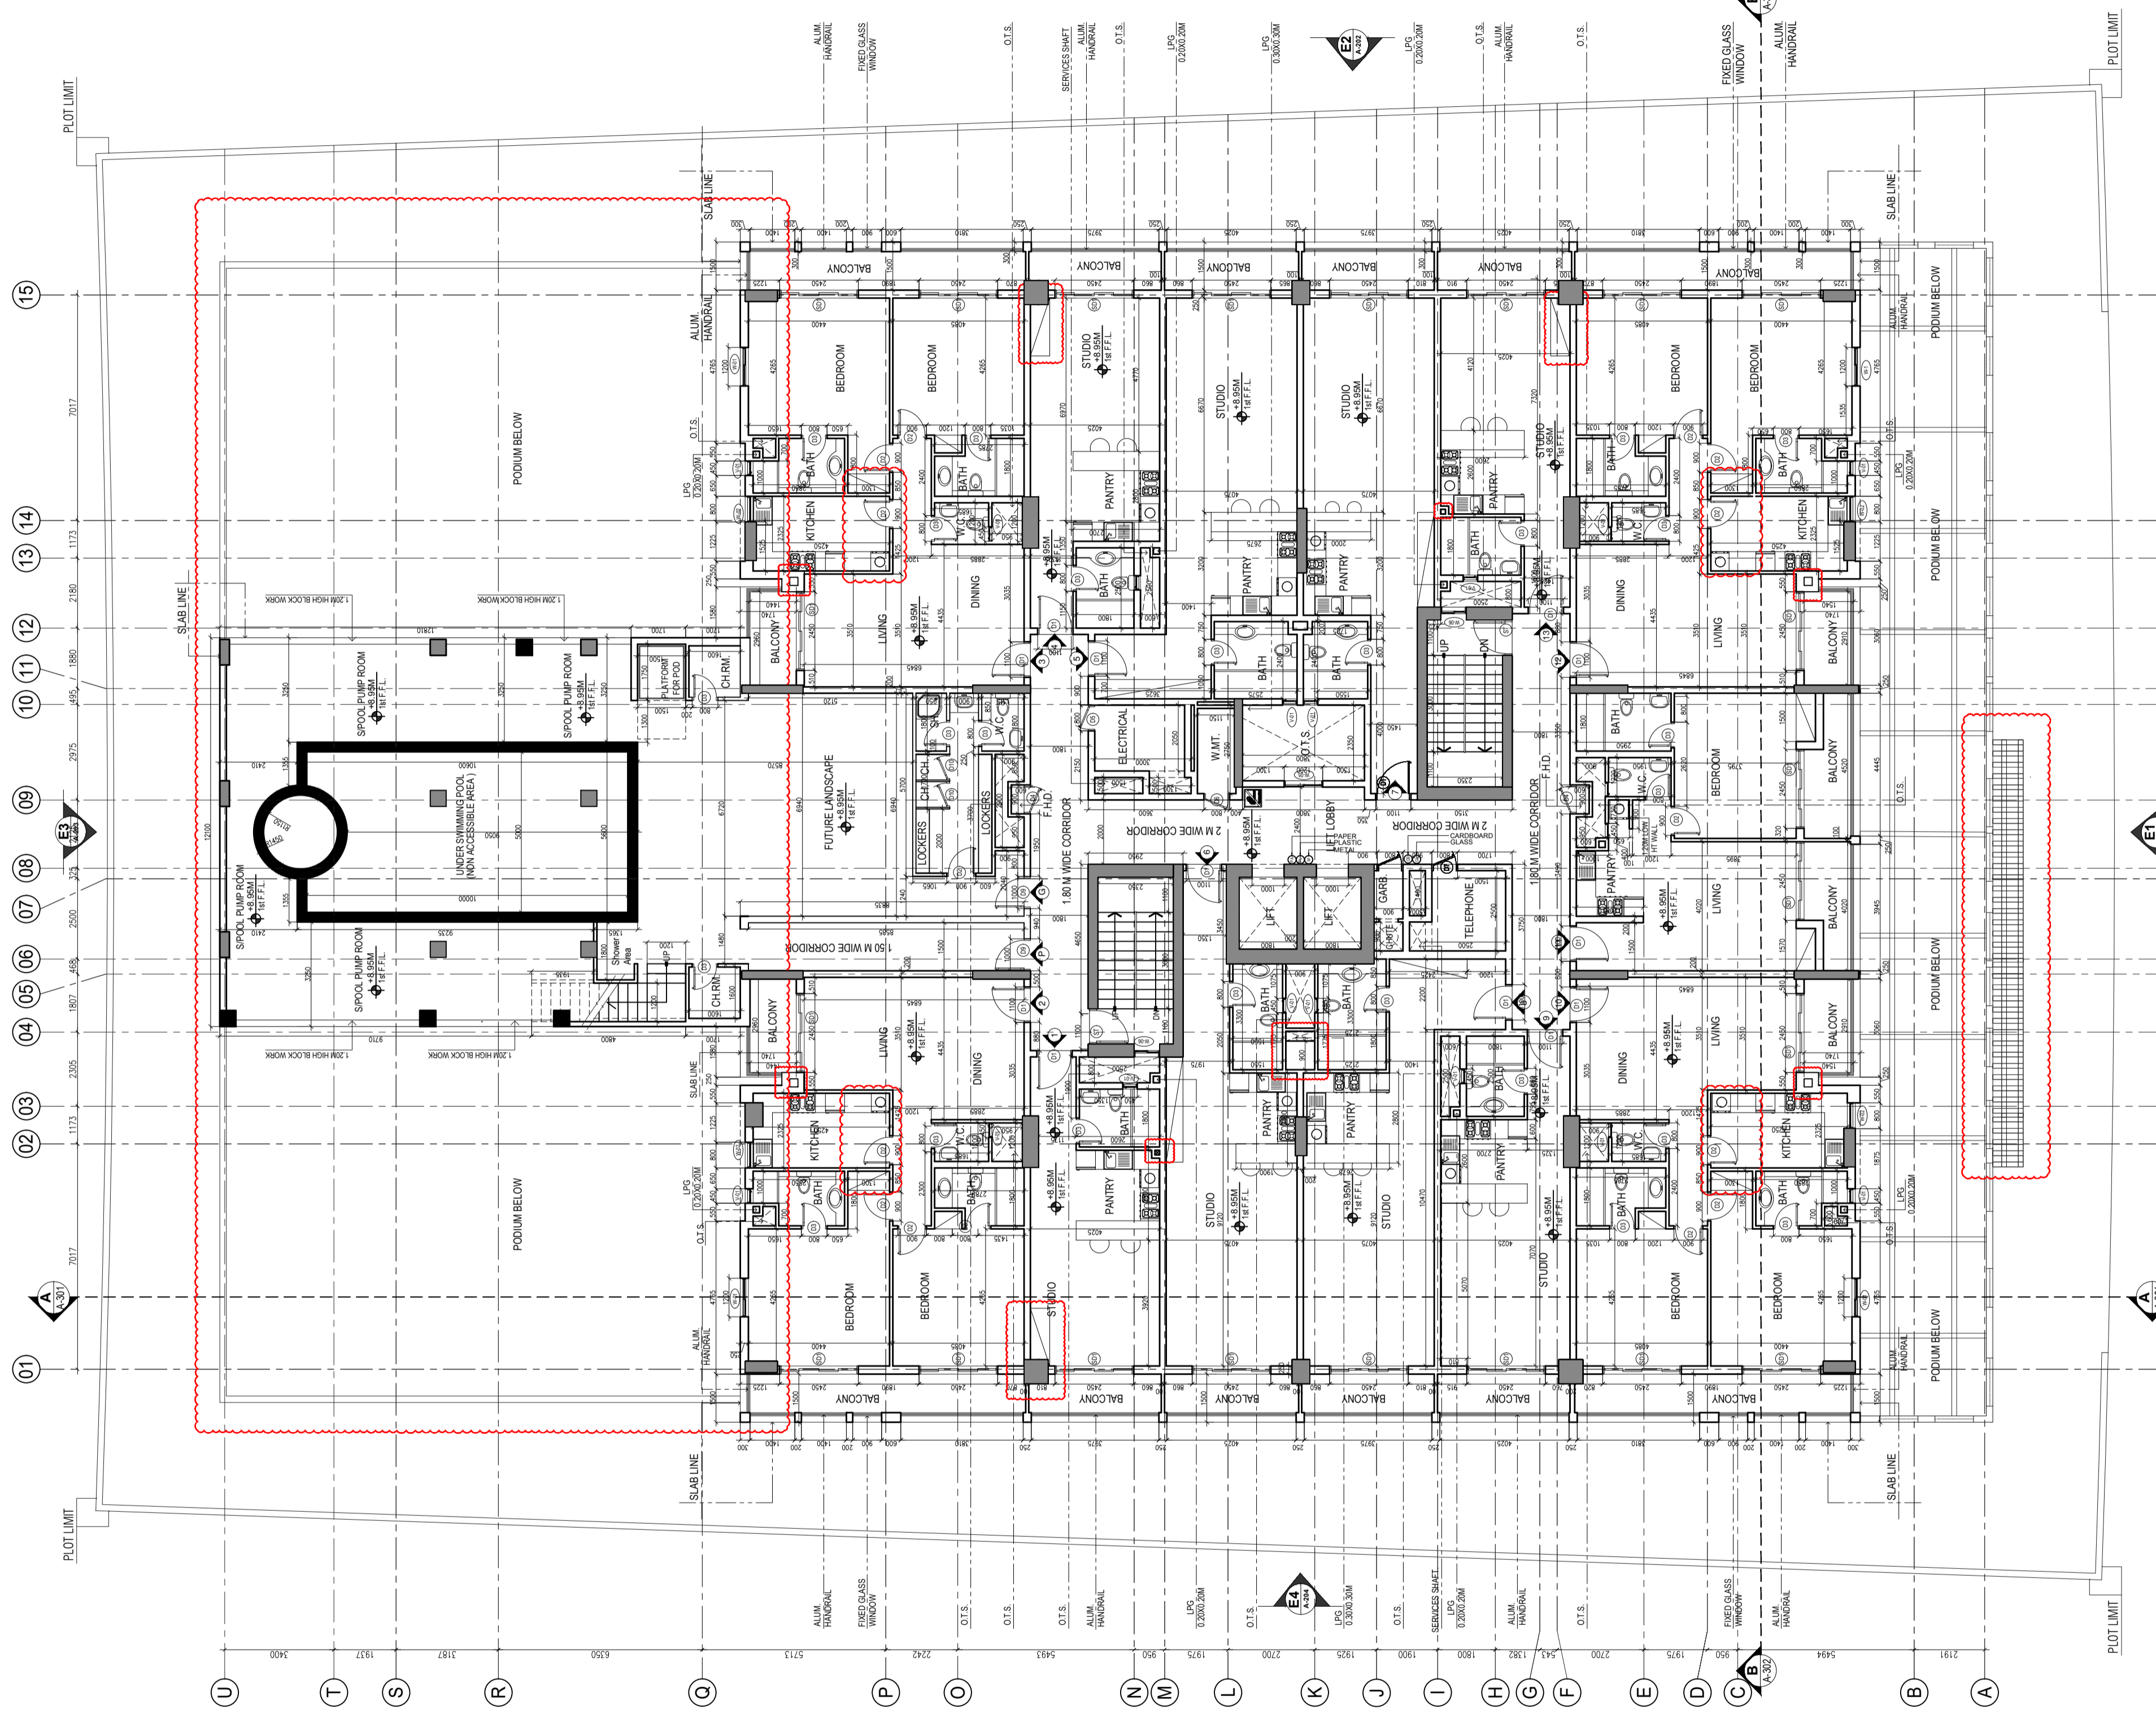

A FIRST FLOOR PLAN
A-104
1:100

- GENERAL NOTES**
- THIS DRAWING IS THE PROPERTY OF :
na architects engineering consultancy
P.O.Box 237347, DUBAI.
IT IS FORBIDDEN TO PRODUCE ITS CONTENTS IN ANY FORM, EXCEPT FOR THE INTENDED PURPOSE.
 - THIS DRAWING IS NOT TO BE SCALED. THE STATED DIMENSIONS ONLY ARE TO BE CONSIDERED.
 - THE DISCREPANCIES ARE TO BE BROUGHT TO THE ATTENTION AND RESOLVED BY NA ARCHITECTS ENGINEERING CONSULTANCY BEFORE COMMENCEMENT OF ANY WORK.
 - ALWAYS FOLLOWED WRITTEN DIMENSION.

- LEGEND**
- KEY PLAN**
- NO SMOKING
 - BIN FOR PAPER
 - BIN FOR PLASTIC
 - BIN FOR METAL
 - BIN FOR CARDBOARD
 - BIN FOR GLASS

AS BUILT

CONTRACTORS REPRESENTATIVES	DATE	INITIALS
CM / PROJECT ENGINEER		
ARCHITECT		
STRUCTURAL ENGINEER		
SUBCONTRACTORS REPRESENTATIVES	DATE	INITIALS
MEP. COORDINATOR		
MECHANICAL ENGINEER		
ELECTRICAL ENGINEER		

PROJECT:

**RESIDENTIAL BUILDING
G+1P+7+ROOF**

REVIEW STATUS A B C D

DATE REVIEWED _____

REVIEWED BY _____

DATE: _____

Rev	Date	Description	Drawn	Checked
AB	05/11/2019	AS BUILT DRAWING SUBMISSION	RCF	
AB	02/11/2019	AS BUILT DRAWING SUBMISSION	RCF	Engr. Hazem

CLIENT :

**MR. MASOOD ABDULLA MOHD
ABDULAZIZ AL ZAROONI**

LOCATION IC- PHASE 3	PLOT No. IC3-H-40
--------------------------------	-----------------------------

PRINCIPAL CONSULTANT:

NA ARCHITECTS ENGINEERING CONSULTANCY
 ان ايه آر كستنس للاستشارات الهندسية
 OFFICE 2601, THE EXCHANGE TOWER
 BUSINESS BAY - DUBAI - U.A.E
 TEL: 04-777828 P.O.BOX: 237347
 www.naarchitects.net

MAIN CONTRACTOR :

MC **ALMABNA CONTRACTING COMPANY**
 2019-2020
 2017-2018
 2016-2017
 P.O.Box: 237346

SUB CONTRACTOR :


MC **ALMABNA CONTRACTING COMPANY**
 2019-2020
 2017-2018
 2016-2017
 P.O.Box: 237346

DRAWING TITLE:

1st FLOOR PLAN

DRAWN BY: RCF	JOB NO: P-10	DATE: 05.11.2019
CHECKED BY: Engr. Hazem	SCALE: 1:100	SHEET SIZE: A1
PROJECT NO: NA/IC/B103 NA/IC/B103/15	SHOP DRAWING NO:	REV: AB

AS BUILT

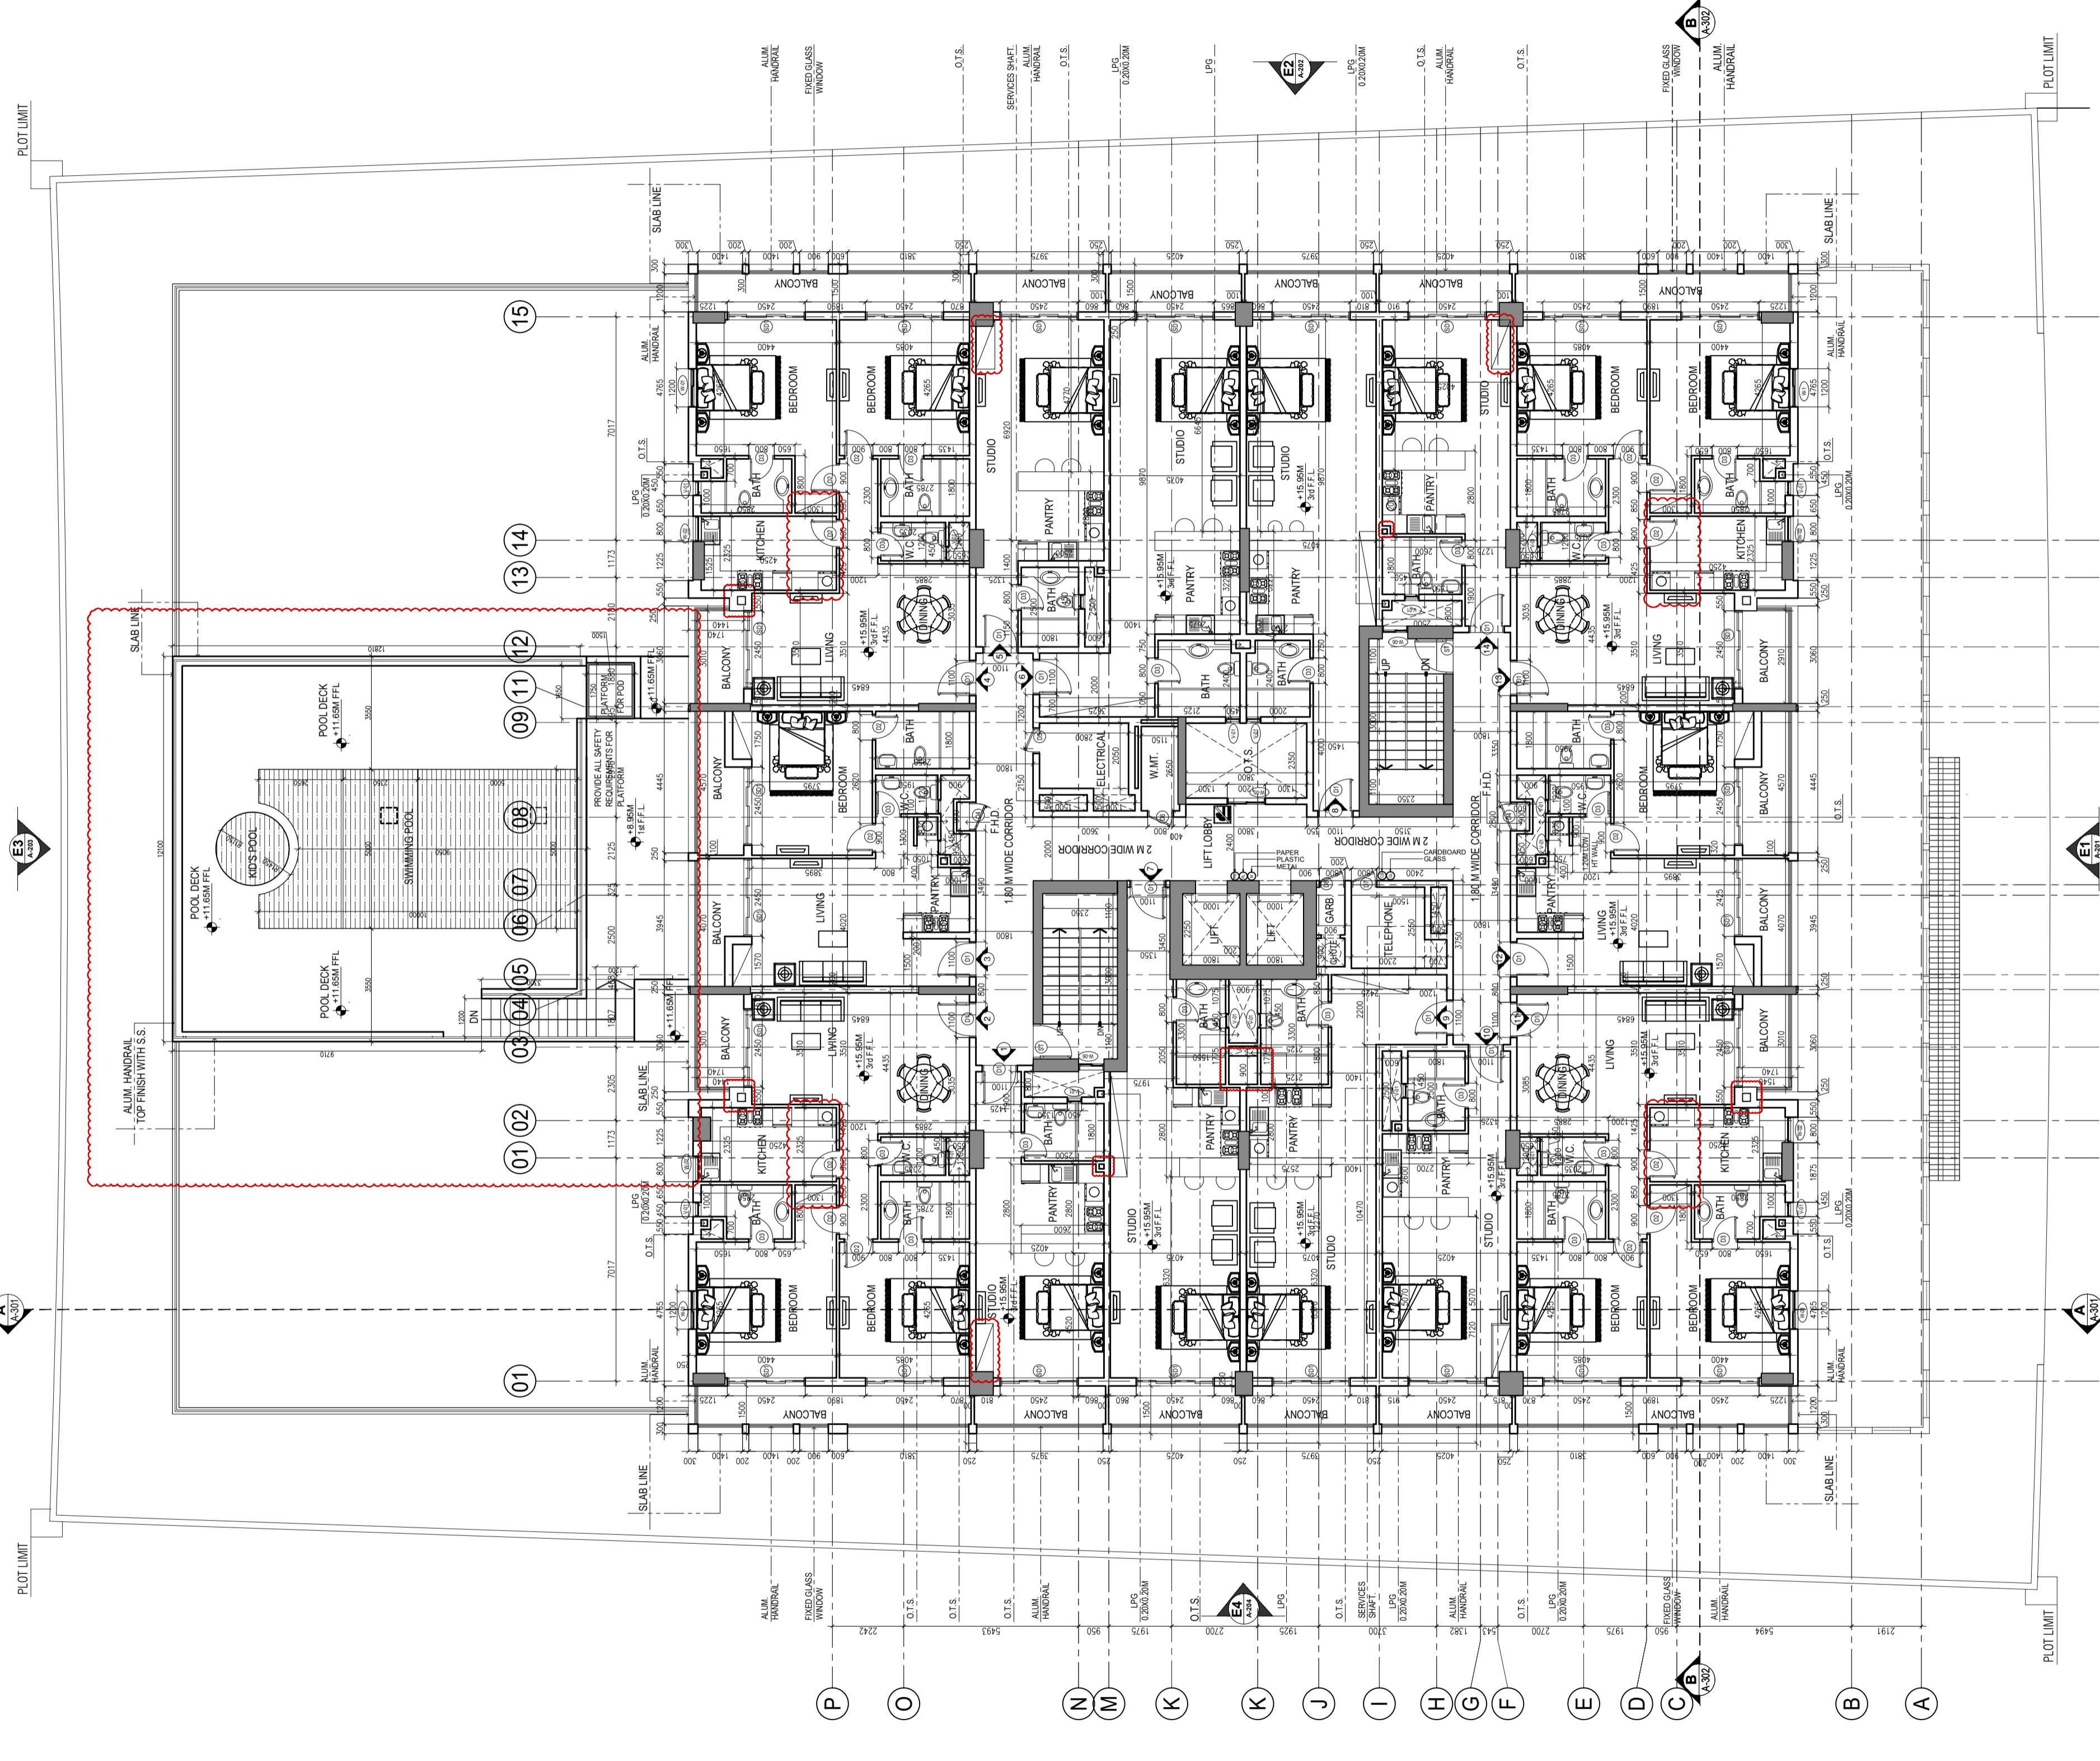

A 2ND & 3RD FLOOR PLAN
A-105 1:100

AS BUILT

- GENERAL NOTES**
- THIS DRAWING IS THE PROPERTY OF :
na architects engineering consultancy
P.O.Box 237347, DUBAI.
IT IS FORBIDDEN TO PRODUCE ITS CONTENTS IN ANY FORM, EXCEPT FOR THE INTENDED PURPOSE.
 - THIS DRAWING IS NOT TO BE SCALED. THE STATED DIMENSIONS ONLY ARE TO BE CONSIDERED.
 - THE DISCREPANCIES ARE TO BE BROUGHT TO THE ATTENTION AND RESOLVED BY NA ARCHITECTS ENGINEERING CONSULTANCY BEFORE COMMENCEMENT OF ANY WORK.
 - ALWAYS FOLLOWED WRITTEN DIMENSION.

- LEGEND**
- KEY PLAN**
- NO SMOKING
 - BIN FOR PAPER
 - BIN FOR PLASTIC
 - BIN FOR METAL
 - BIN FOR CARDBOARD
 - BIN FOR GLASS

AS BUILT

CONTRACTORS REPRESENTATIVES	DATE	INITIALS
CM / PROJECT ENGINEER		
ARCHITECT		
STRUCTURAL ENGINEER		
SUBCONTRACTORS REPRESENTATIVES	DATE	INITIALS
MEP. COORDINATOR		
MECHANICAL ENGINEER		
ELECTRICAL ENGINEER		

PROJECT:

**RESIDENTIAL BUILDING
G+1P+7+ROOF**

REVIEW STATUS: A B C D

DATE REVIEWED: _____

REVIEWED BY: _____

DATE: _____

Rev	Date	Description	Drawn	Checked
AB	05/11/2019	AS BUILT DRAWING SUBMISSION	RCF	Engr. Hazem
AB	02/11/2019	AS BUILT DRAWING SUBMISSION	RCF	Engr. Hazem

CLIENT:

**MR. MASOOD ABDULLA MOHD
ABDULAZIZ AL ZAROONI**

LOCATION IC- PHASE 3	PLOT No. IC3-H-40
-------------------------	----------------------

PRINCIPAL CONSULTANT:

OFFICE 2801 / THE EXCHANGE TOWER
BUSINESS BAY - DUBAI - U.A.E
TEL: 04-277820 P.O. BOX: 237347
www.naarchitects.net

MAIN CONTRACTOR:

SUB CONTRACTOR:

DRAWING TITLE:
2ND & 3RD FLOOR PLAN

DRAWN BY: RCF	JOB NO: P-10	DATE: 05.11.2019
CHECKED BY: Engr. Hazem	SCALE: 1:100	SHEET SIZE: A1
PROJECT NO: NA/IC/B103 NA/IC/B103/15	SHOP DRAWING NO:	REV: AB



- GENERAL NOTES**
- THIS DRAWING IS THE PROPERTY OF :
na architects engineering consultancy
P.O.Box 237347, DUBAI.
IT IS FORBIDDEN TO PRODUCE ITS CONTENTS IN ANY FORM, EXCEPT FOR THE INTENDED PURPOSE.
 - THIS DRAWING IS NOT TO BE SCALED. THE STATED DIMENSIONS ONLY ARE TO BE CONSIDERED.
 - THE DISCREPANCIES ARE TO BE BROUGHT TO THE ATTENTION AND RESOLVED BY NA ARCHITECTS ENGINEERING CONSULTANCY BEFORE COMMENCEMENT OF ANY WORK.
 - ALWAYS FOLLOWED WRITTEN DIMENSION.

LEGEND

- KEY PLAN**
- NO SMOKING
 - BIN FOR PAPER
 - BIN FOR PLASTIC
 - BIN FOR METAL
 - BIN FOR CARDBOARD
 - BIN FOR GLASS

AS BUILT

CONTRACTORS REPRESENTATIVES	DATE	INITIALS
CM / PROJECT ENGINEER		
ARCHITECT		
STRUCTURAL ENGINEER		
SUBCONTRACTORS REPRESENTATIVES	DATE	INITIALS
MEP. COORDINATOR		
MECHANICAL ENGINEER		
ELECTRICAL ENGINEER		

PROJECT: **RESIDENTIAL BUILDING G+1P+7+ROOF**

REVIEW STATUS: A B C D

DATE REVIEWED: _____

REVIEWED BY: _____

DATE: _____

Rev	Date	Description	Drawn	Checked
AB	02/11/2019	AS BUILT DRAWING SUBMISSION	RCF	Engr. Hazem

CLIENT: **MR. MASOOD ABDULLA MOHD ABDULAZIZ AL ZAROONI**

LOCATION: **IC- PHASE 3** PLOT No. **IC3-H-40**

PRINCIPAL CONSULTANT:
ان ايه اركيكتس للاستشارات الهندسية
 NA ARCHITECTS ENGINEERING CONSULTANCY
 OFFICE 2601 / THE EXCHANGE TOWER
 BUSINESS BAY - DUBAI - U.A.E
 TEL: 04-2777629 P.O. BOX: 237347
 WWW.NAARCHITECTS.COM

MAIN CONTRACTOR:
ALMABNA CONTRACTING COMPANY
 20th Floor, The Exchange Tower
 Business Bay - Dubai - U.A.E
 P.O. Box: 233146

SUB CONTRACTOR:
ALMABNA CONTRACTING COMPANY
 20th Floor, The Exchange Tower
 Business Bay - Dubai - U.A.E
 P.O. Box: 233146


DRAWING TITLE: **4TH FLOOR PLAN**

DRAWN BY: **RCF** JOB NO: **P-10** DATE: **02.11.2019**


CHECKED BY: **Engr. Hazem** SCALE: **1:100** SHEET SIZE: **A1**

PROJECT NO: **NA/IC/B103** SHOP DRAWING NO: _____ REV: **AB**

AS BUILT

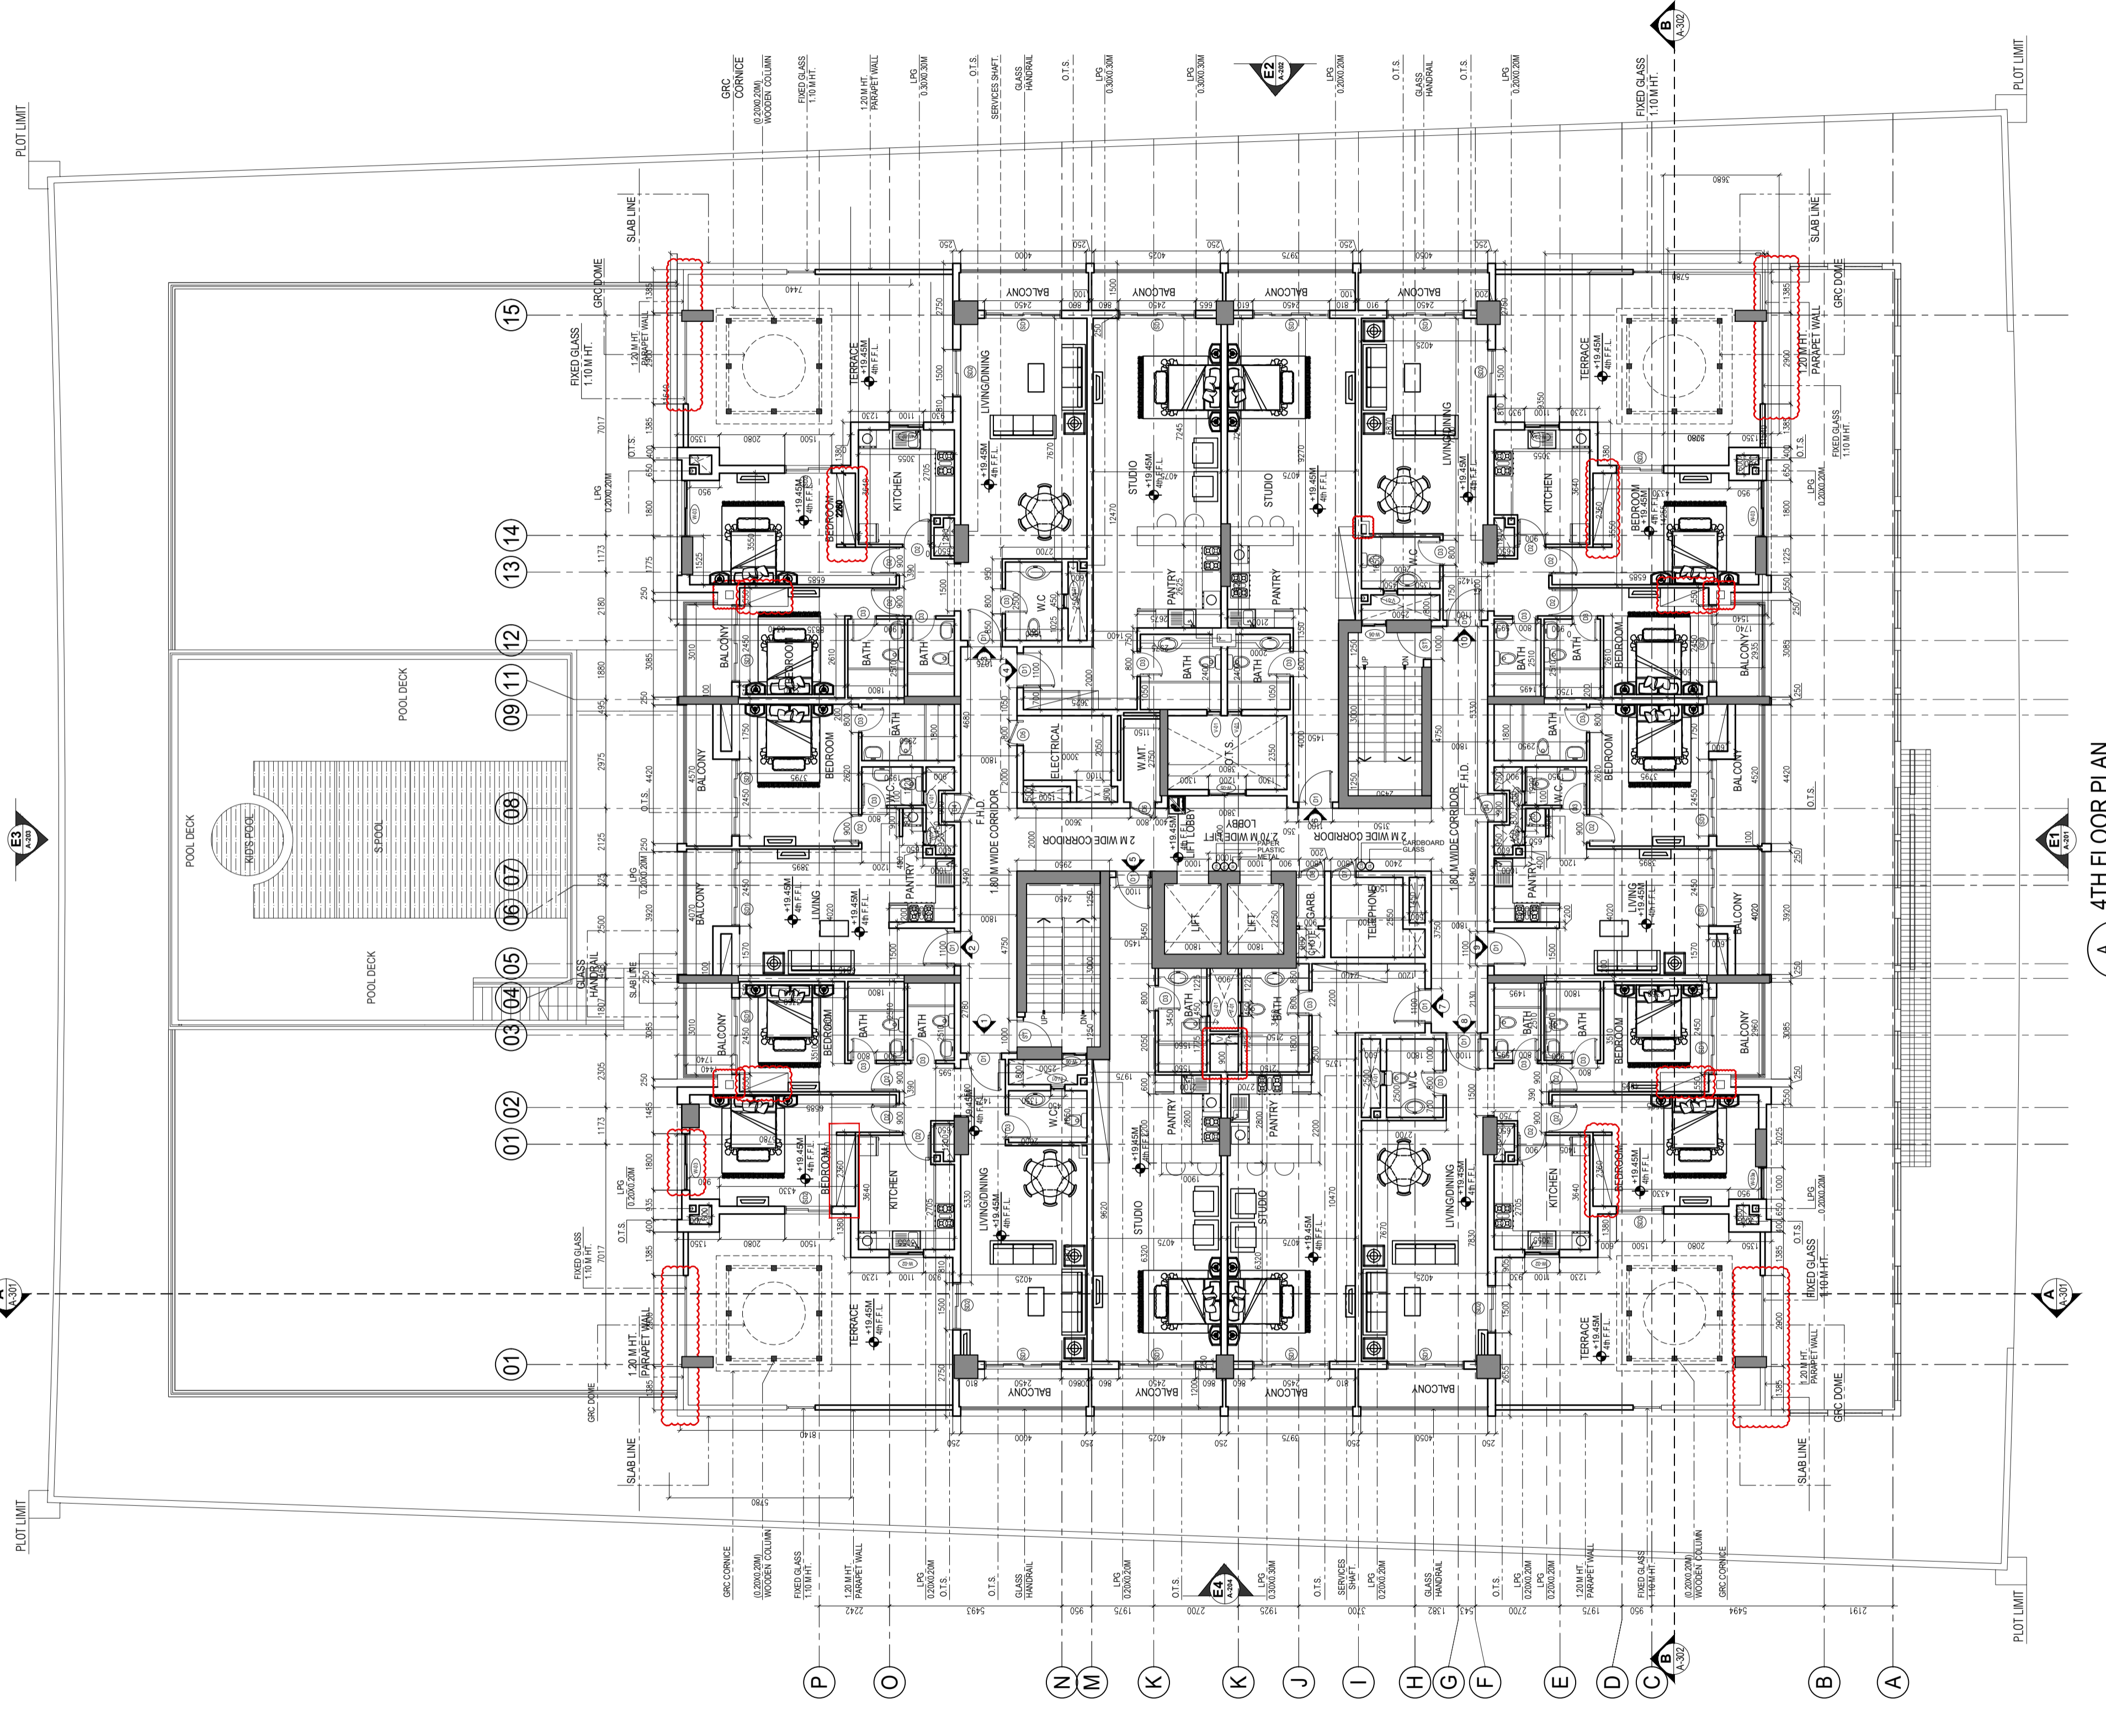

4TH FLOOR PLAN
A-106

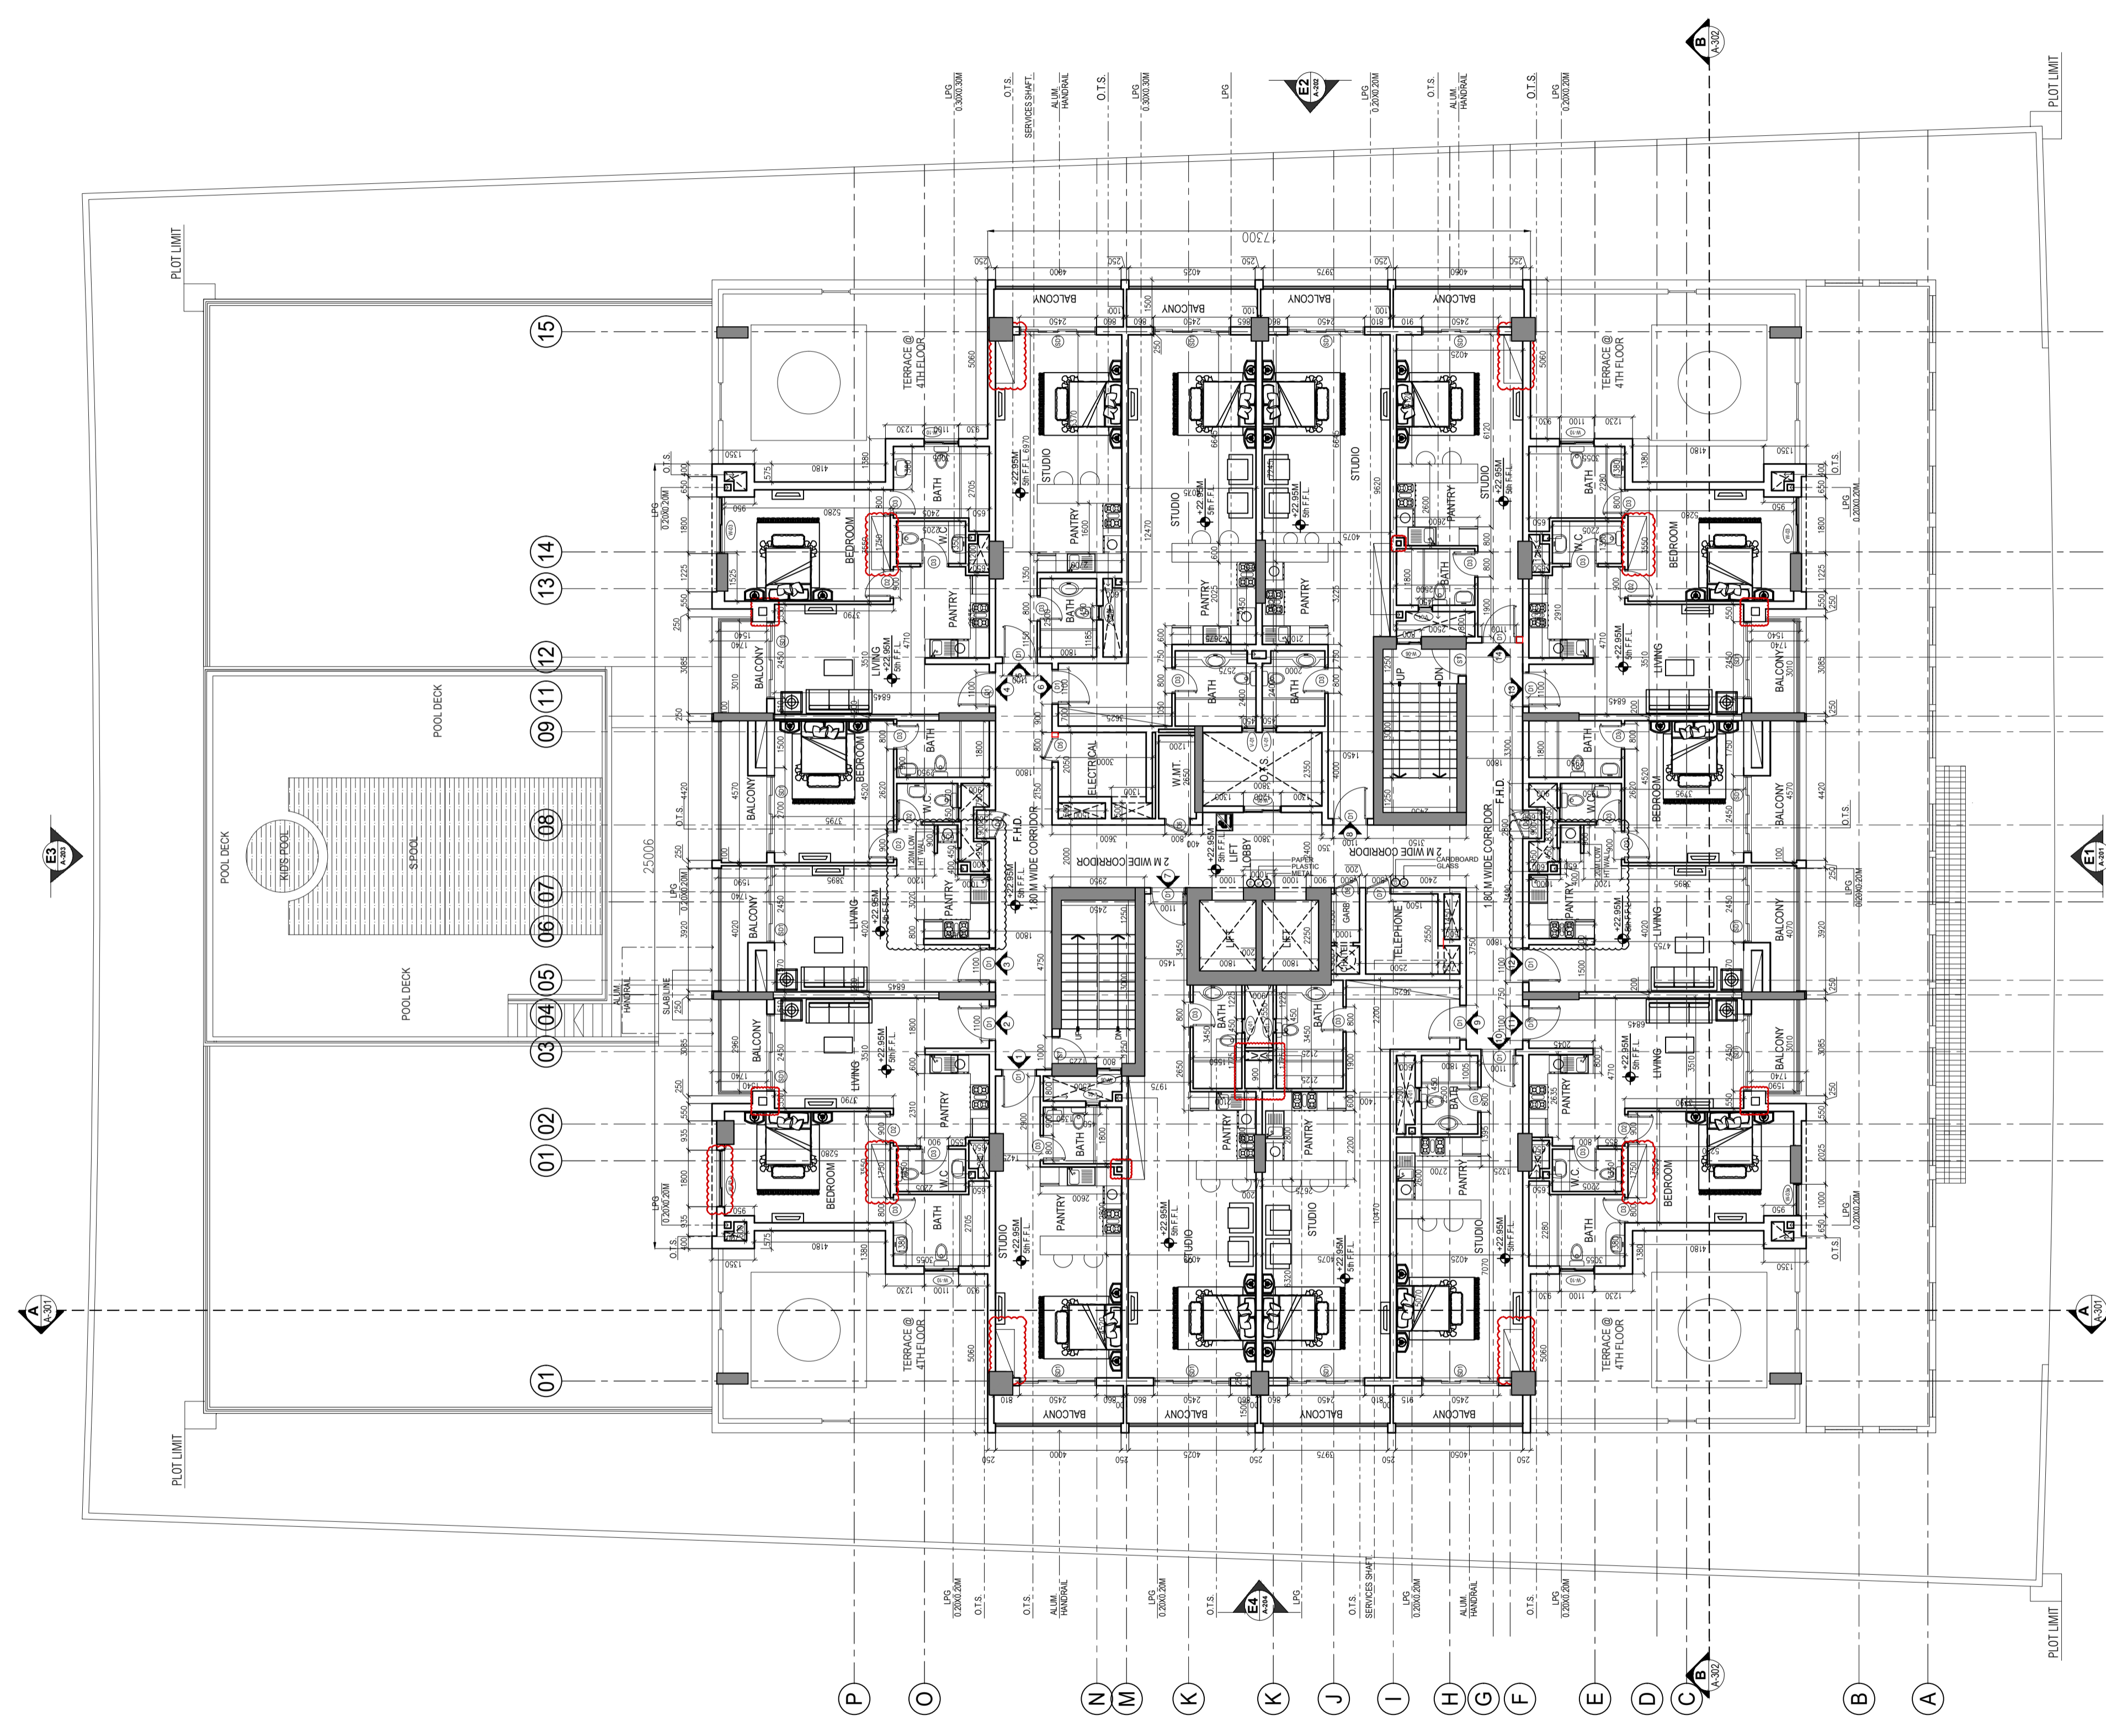

5TH FLOOR PLAN
A-107
1:100

- GENERAL NOTES**
- THIS DRAWING IS THE PROPERTY OF :
na architects engineering consultancy
P.O.Box 237347, DUBAI.
IT IS FORBIDDEN TO PRODUCE ITS CONTENTS IN ANY FORM, EXCEPT FOR THE INTENDED PURPOSE.
 - THIS DRAWING IS NOT TO BE SCALED. THE STATED DIMENSIONS ONLY ARE TO BE CONSIDERED.
 - THE DISCREPANCIES ARE TO BE BROUGHT TO THE ATTENTION AND RESOLVED BY NA ARCHITECTS ENGINEERING CONSULTANCY BEFORE COMMENCEMENT OF ANY WORK.
 - ALWAYS FOLLOWED WRITTEN DIMENSION.

- LEGEND**
- KEY PLAN**
- NO SMOKING
 - BIN FOR PAPER
 - BIN FOR PLASTIC
 - BIN FOR METAL
 - BIN FOR CARDBOARD
 - BIN FOR GLASS

AS BUILT

CONTRACTORS REPRESENTATIVES	DATE	INITIALS
CM / PROJECT ENGINEER		
ARCHITECT		
STRUCTURAL ENGINEER		
SUBCONTRACTORS REPRESENTATIVES	DATE	INITIALS
MEP. COORDINATOR		
MECHANICAL ENGINEER		
ELECTRICAL ENGINEER		

PROJECT: RESIDENTIAL BUILDING G+1P+7+ROOF				
REVIEW STATUS	<input type="checkbox"/> A	<input type="checkbox"/> B	<input type="checkbox"/> C	<input type="checkbox"/> D
DATE REVIEWED				
REVIEWED BY				

Rev	Date	Description	Drawn	Checked
AB	02/11/2019	AS BUILT DRAWING SUBMISSION	RCF	Engr. Hazem

CLIENT :
**MR. MASOOD ABDULLA MOHD
ABDULAZIZ AL ZAROONI**

LOCATION : IC- PHASE 3
PLOT No. : IC3-H-40

PRINCIPAL CONSULTANT:
ان ايه آر كيكتس للاستشارات الهندسية
 NA ARCHITECTS ENGINEERING CONSULTANCY
 OFFICE 2601 / THE EXCHANGE TOWER
 BUSINESS BAY - DUBAI - U.A.E.
 TEL: 04-2777825 P.O.BOX- 237347
 www.naarchitects.net

MAIN CONTRACTOR :
ALMABNA CONTRACTING COMPANY
 20th Floor - The Exchange Tower
 Business Bay - Dubai - U.A.E.
 P.O. Box: 237347

SUB CONTRACTOR :
ALMABNA CONTRACTING COMPANY
 20th Floor - The Exchange Tower
 Business Bay - Dubai - U.A.E.
 P.O. Box: 237347

DRAWING TITLE:
5TH FLOOR PLAN

DRAWN BY: RCF	JOB NO: P-10	DATE: 02.11.2019
CHECKED BY: Engr. Hazem	SCALE: 1:100	SHEET SIZE: A1
PROJECT NO: NA/IC/B103	SHOP DRAWING NO:	REV: AB

AS BUILT



- GENERAL NOTES**
1. THIS DRAWING IS THE PROPERTY OF :
na architects engineering consultancy
P.O.Box 237347, DUBAI.
IT IS FORBIDDEN TO PRODUCE ITS CONTENTS IN ANY FORM, EXCEPT FOR THE INTENDED PURPOSE.
 2. THIS DRAWING IS NOT TO BE SCALED. THE STATED DIMENSIONS ONLY ARE TO BE CONSIDERED.
 3. THE DISCREPANCIES ARE TO BE BROUGHT TO THE ATTENTION AND RESOLVED BY NA ARCHITECTS ENGINEERING CONSULTANCY BEFORE COMMENCEMENT OF ANY WORK.
 4. ALWAYS FOLLOWED WRITTEN DIMENSION.

LEGEND

- KEY PLAN**
- NO SMOKING
 - BIN FOR PAPER
 - BIN FOR PLASTIC
 - BIN FOR METAL
 - BIN FOR CARDBOARD
 - BIN FOR GLASS

AS BUILT

CONTRACTORS REPRESENTATIVES	DATE	INITIALS
CM / PROJECT ENGINEER		
ARCHITECT		
STRUCTURAL ENGINEER		
SUBCONTRACTORS REPRESENTATIVES	DATE	INITIALS
MEP. COORDINATOR		
MECHANICAL ENGINEER		
ELECTRICAL ENGINEER		

PROJECT:
**RESIDENTIAL BUILDING
G+1P+7+ROOF**

REVIEW STATUS	A	B	C	D
DATE REVIEWED				
REVIEWED BY				
DATE:				

Rev	Date	Description	Drawn	Checked
AB	02/11/2019	AS BUILT DRAWING SUBMISSION	RCF	Engr. Hazem

CLIENT:
**MR. MASOOD ABDULLA MOHD
ABDULAZIZ AL ZAROONI**

LOCATION
IC- PHASE 3

PLOT No.
IC3-H-40

PRINCIPAL CONSULTANT:

NA ARCHITECTS ENGINEERING CONSULTANCY
 ان ايه آر اركيكتس للاستشارات الهندسية
 OFFICE 2601, THE EXCHANGE TOWER
 BUSINESS BAY - DUBAI - U.A.E
 TEL: 04-2777829 P.O.BOX: 237347
 www.naarchitects.net

MAIN CONTRACTOR:


MC
ALMABNA CONTRACTING COMPANY
 P.O. BOX: 233746
 DUBAI - U.A.E
 TEL: 04-2777829
 P.O. BOX: 233746

SUB CONTRACTOR:

MC
ALMABNA CONTRACTING COMPANY
 P.O. BOX: 233746
 DUBAI - U.A.E
 TEL: 04-2777829
 P.O. BOX: 233746


DRAWING TITLE:
6TH FLOOR PLAN

DRAWN BY: RCF	JOB NO: P-10	DATE: 02.11.2019
CHECKED BY: Engr. Hazem	SCALE: 1:100	SHEET SIZE: A1
PROJECT NO: NA/IC/B103 NA/IC/B103/15	SHOP DRAWING NO:	REV: AB

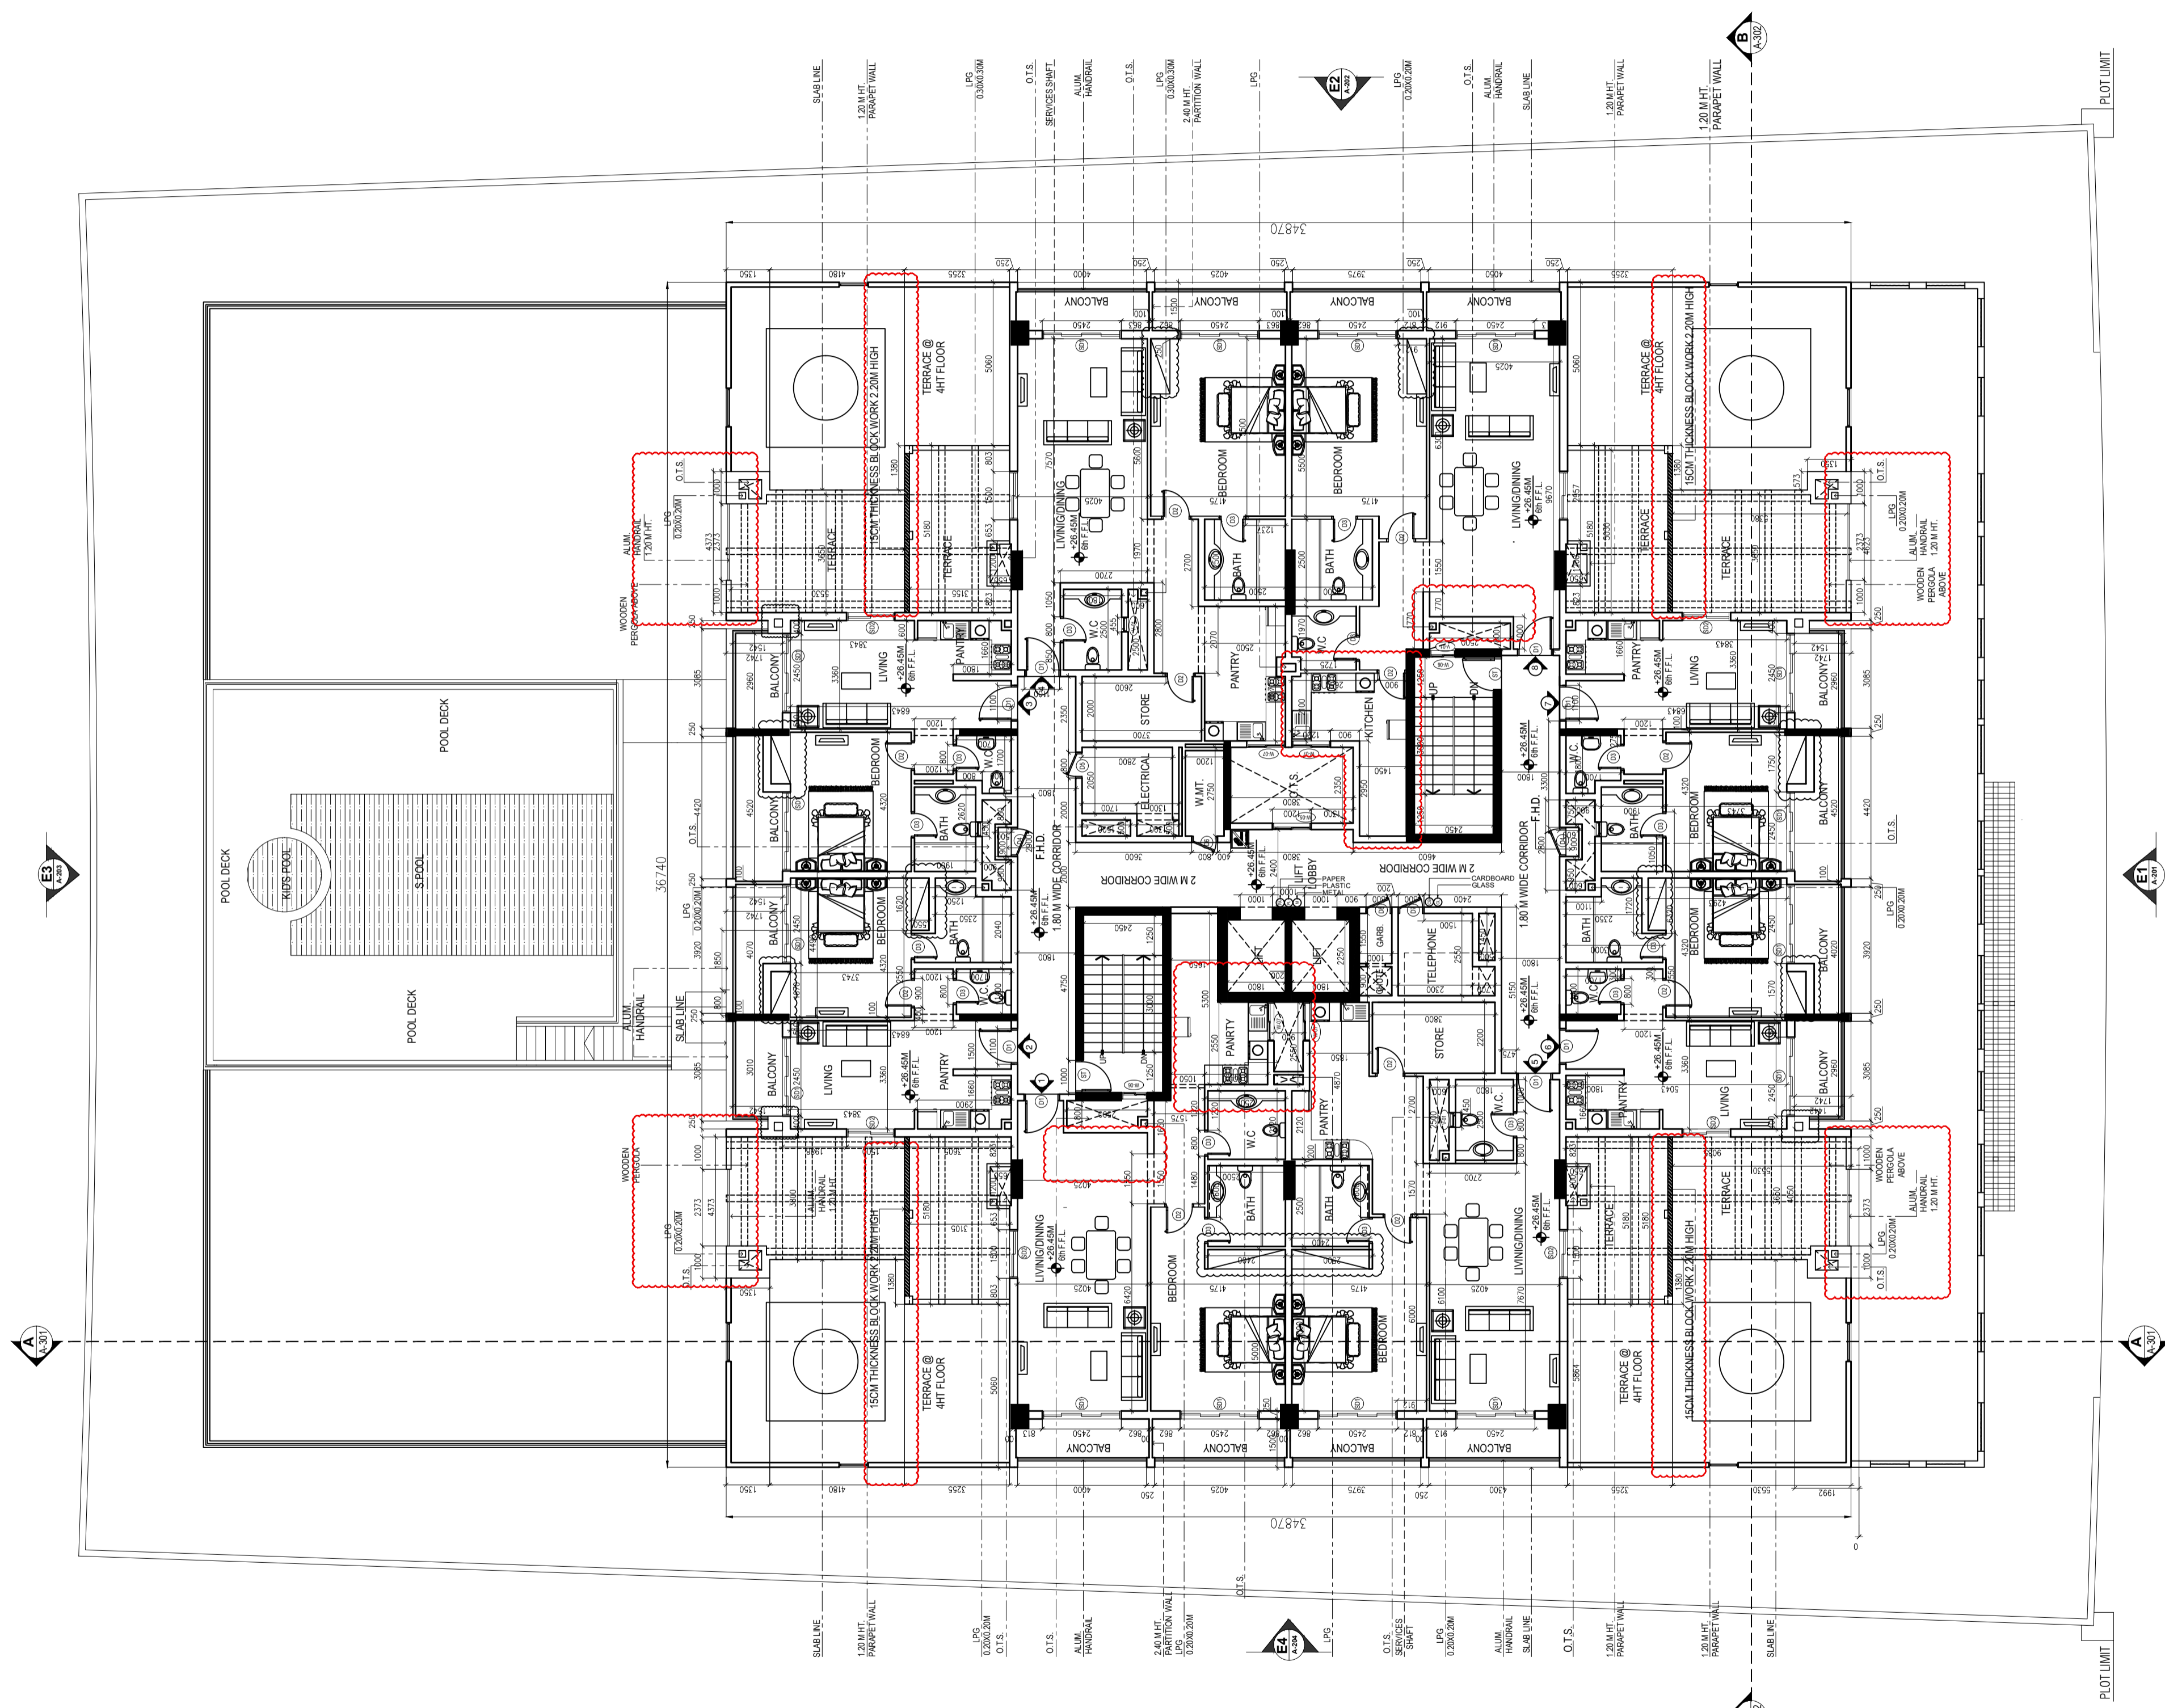

6TH FLOOR PLAN
A-108
1:100

AS BUILT

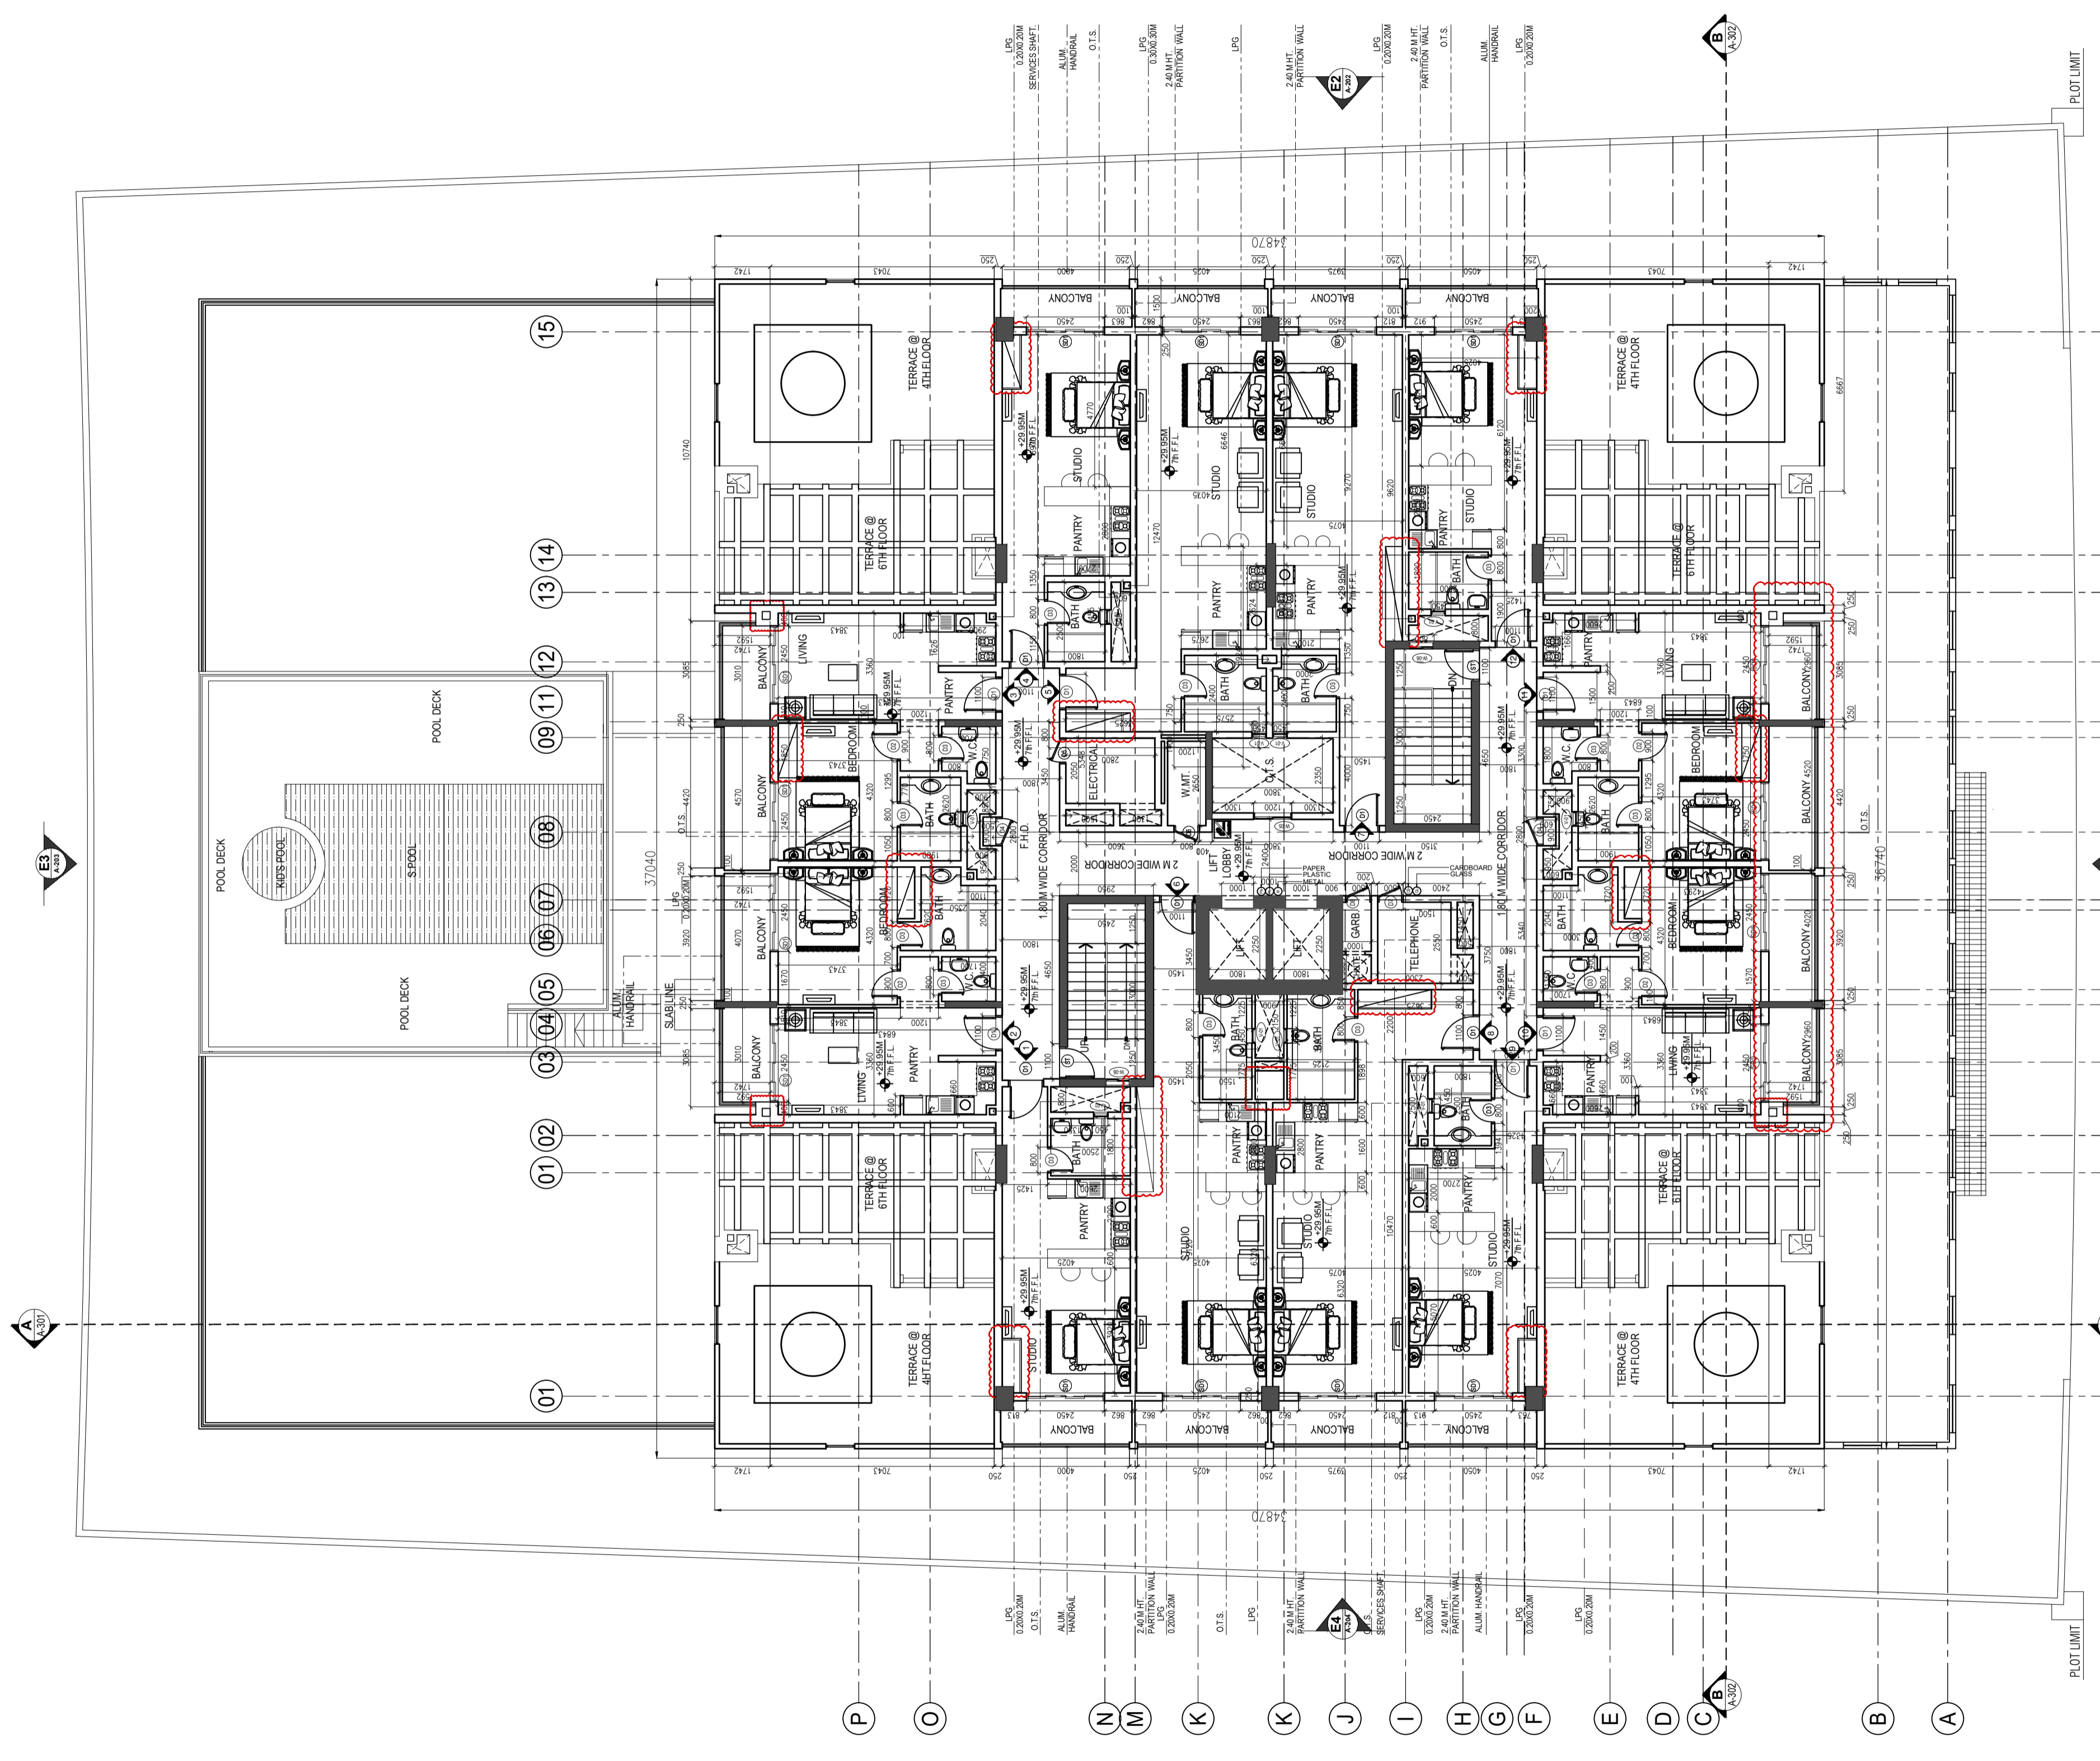

7TH FLOOR PLAN
A-109 1:100

AS BUILT

- GENERAL NOTES
- THIS DRAWING IS THE PROPERTY OF :
na architects engineering consultancy
P.O.Box 237347, DUBAI.
IT IS FORBIDDEN TO PRODUCE ITS CONTENTS IN ANY FORM, EXCEPT FOR THE INTENDED PURPOSE.
 - THIS DRAWING IS NOT TO BE SCALED. THE STATED DIMENSIONS ONLY ARE TO BE CONSIDERED.
 - THE DISCREPANCIES ARE TO BE BROUGHT TO THE ATTENTION AND RESOLVED BY NA ARCHITECTS ENGINEERING CONSULTANCY BEFORE COMMENCEMENT OF ANY WORK.
 - ALWAYS FOLLOWED WRITTEN DIMENSION.

- LEGEND
- KEY PLAN
- NO SMOKING
 - BIN FOR PAPER
 - BIN FOR PLASTIC
 - BIN FOR METAL
 - BIN FOR CARDBOARD
 - BIN FOR GLASS

AS BUILT

CONTRACTORS REPRESENTATIVES	DATE	INITIALS
CM / PROJECT ENGINEER		
ARCHITECT		
STRUCTURAL ENGINEER		
SUBCONTRACTORS REPRESENTATIVES	DATE	INITIALS
MEP. COORDINATOR		
MECHANICAL ENGINEER		
ELECTRICAL ENGINEER		

PROJECT:			
RESIDENTIAL BUILDING G+1P+7+ROOF			
REVIEW STATUS	<input type="checkbox"/> A	<input type="checkbox"/> B	<input type="checkbox"/> C
DATE REVIEWED			
REVIEWED BY			
DATE:			

Rev	Date	Description	Drawn	Checked
AB	02/11/2019	AS BUILT DRAWING SUBMISSION	RCF	Engr. Hazem

CLIENT:

**MR. MASOOD ABDULLA MOHD
ABDULAZIZ AL ZAROONI**

LOCATION	PLOT No.
IC- PHASE 3	IC3-H-40

PRINCIPAL CONSULTANT:

OFFICE 2601 / THE EXCHANGE TOWER
BUSINESS BAY - DUBAI - U.A.E
TEL: 04-777828 P.O.BOX: 237347
www.naarchitects.net


MAIN CONTRACTOR:

SUB CONTRACTOR:

DRAWING TITLE:

7TH FLOOR PLAN

DRAWN BY:	JOB NO:	DATE:
RCF	P-10	02.11.2019
CHECKED BY:	SCALE:	SHEET SIZE:
Engr. Hazem	1:100	A1
PROJECT NO:	SHOP DRAWING NO:	REV:
NA/IC/B103		AB

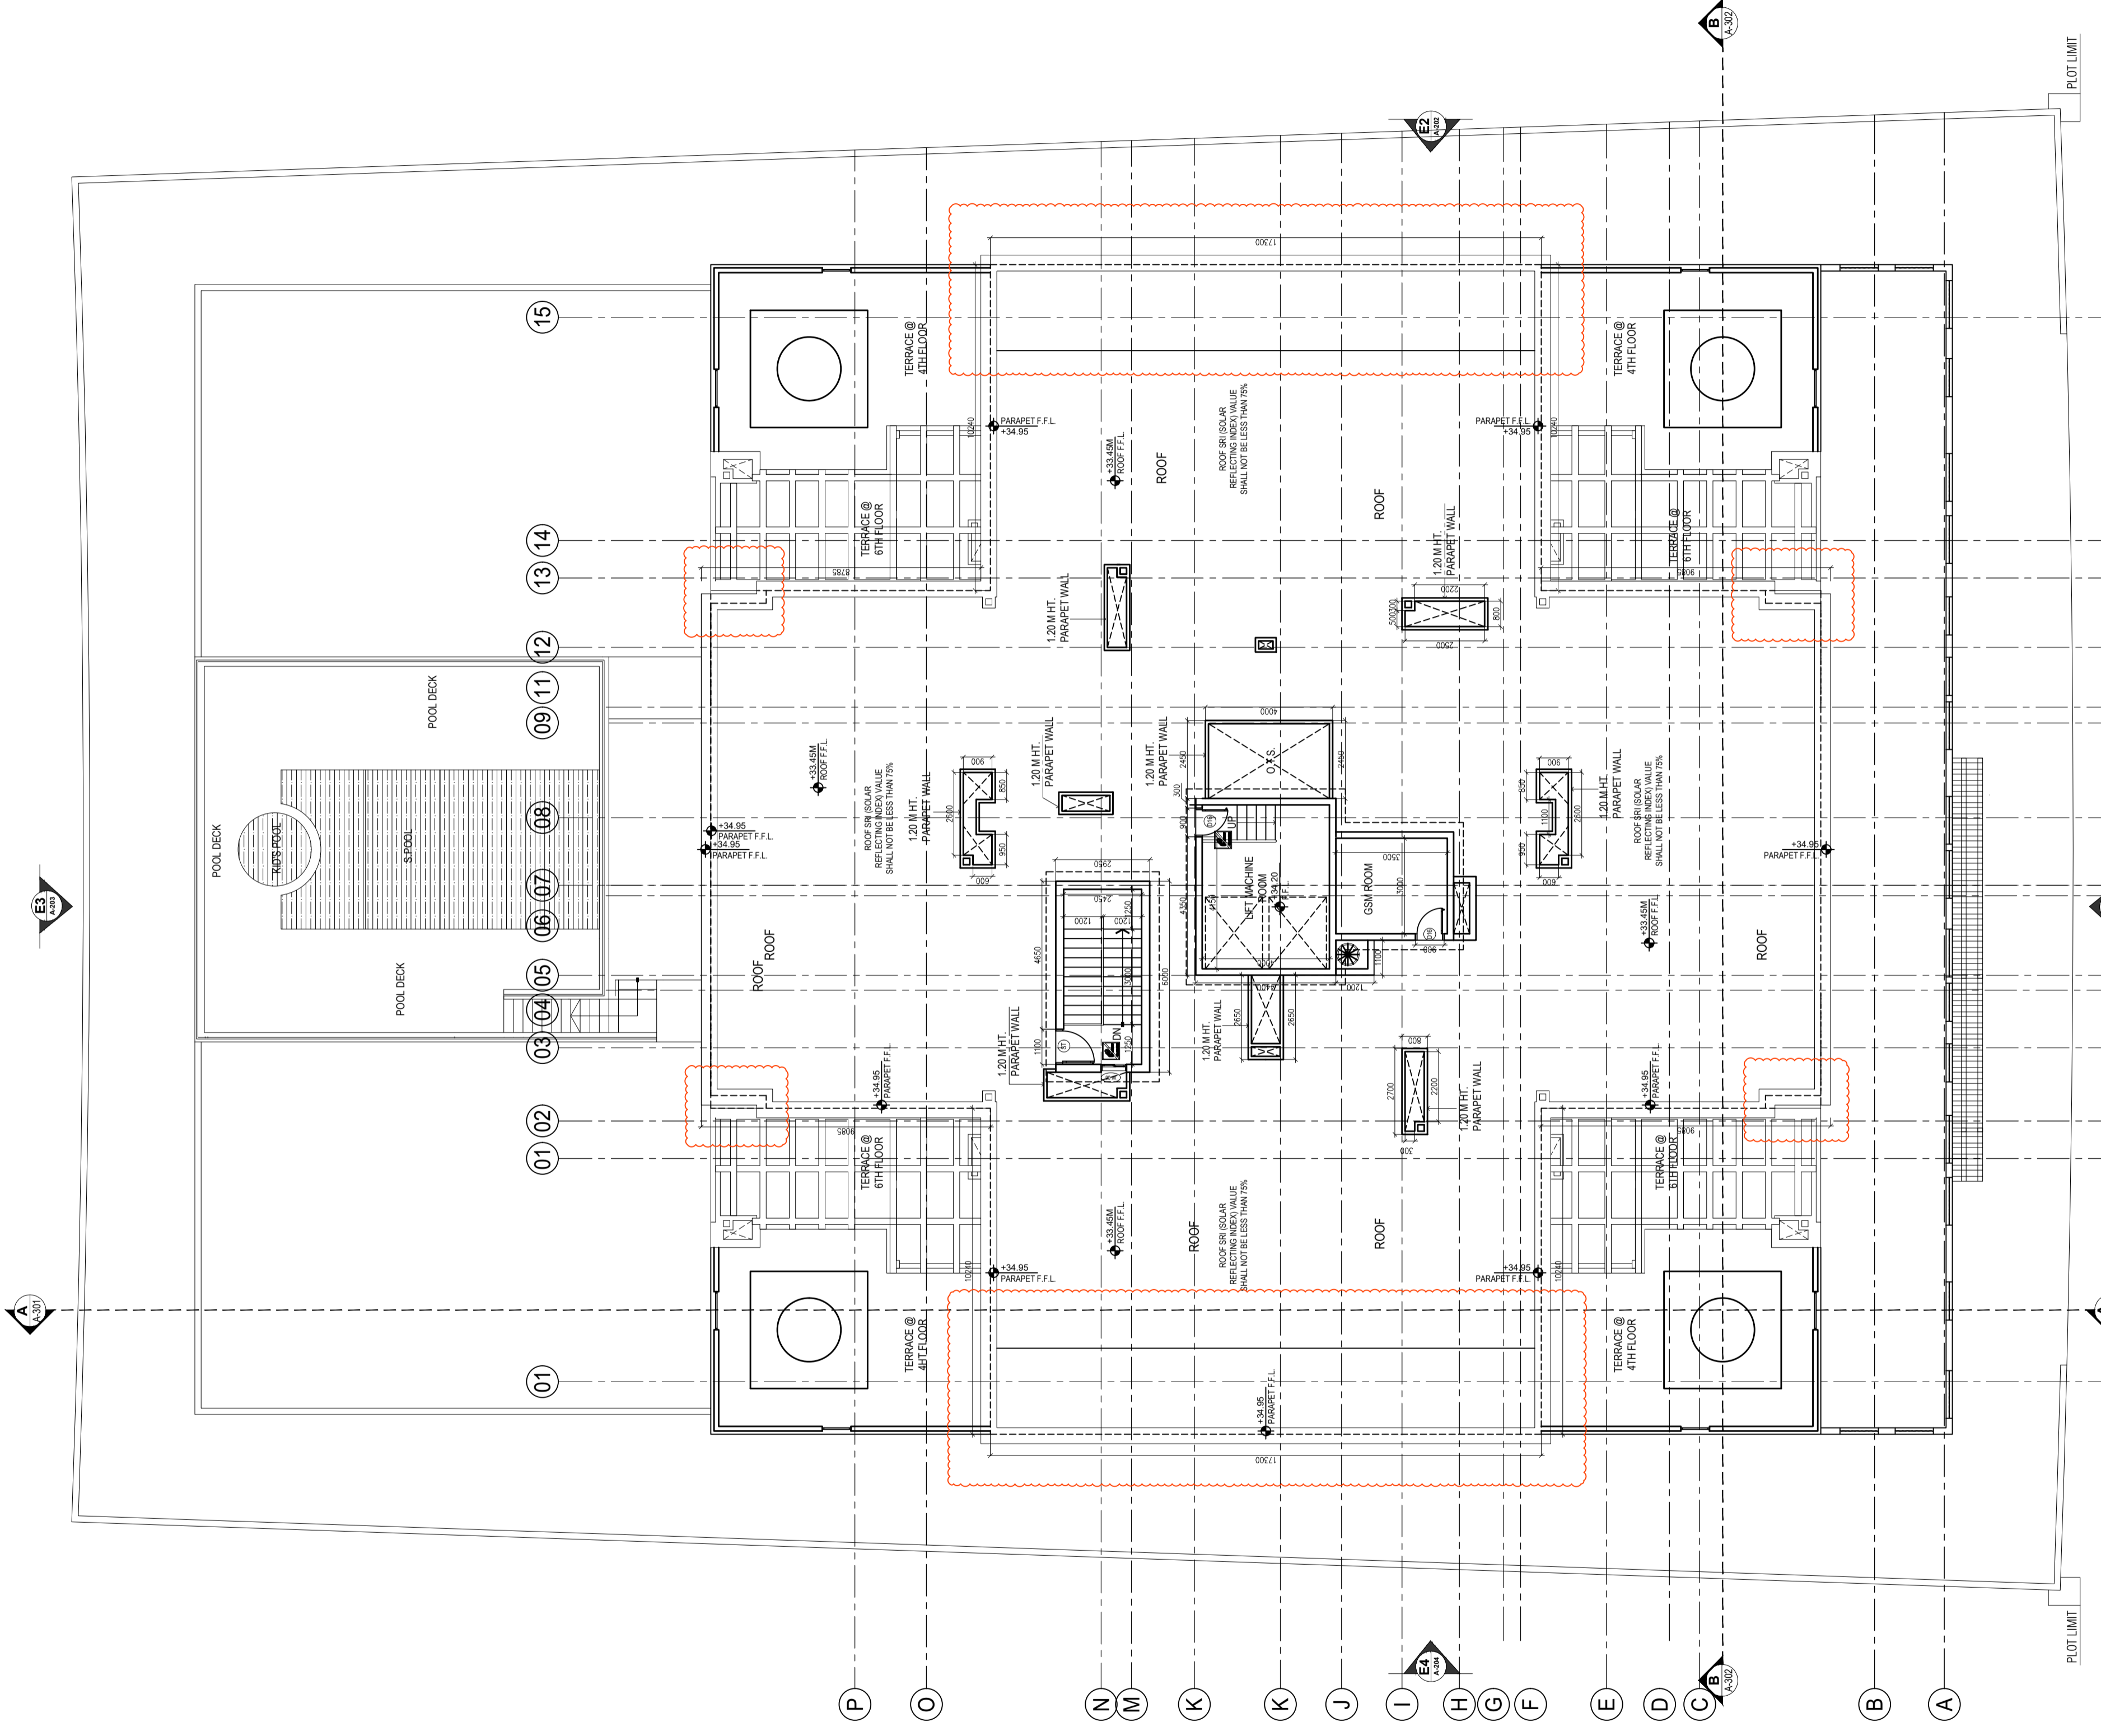

- GENERAL NOTES**
1. THIS DRAWING IS THE PROPERTY OF :
na architects engineering consultancy
P.O.Box 237347, DUBAI.
IT IS FORBIDDEN TO PRODUCE ITS CONTENTS IN ANY FORM, EXCEPT FOR THE INTENDED PURPOSE.
 2. THIS DRAWING IS NOT TO BE SCALED. THE STATED DIMENSIONS ONLY ARE TO BE CONSIDERED.
 3. THE DISCREPANCIES ARE TO BE BROUGHT TO THE ATTENTION AND RESOLVED BY NA ARCHITECTS ENGINEERING CONSULTANCY BEFORE COMMENCEMENT OF ANY WORK.
 4. ALWAYS FOLLOWED WRITTEN DIMENSION.

LEGEND



AS BUILT

CONTRACTORS REPRESENTATIVES	DATE	INITIALS
CM / PROJECT ENGINEER		
ARCHITECT		
STRUCTURAL ENGINEER		
SUBCONTRACTORS REPRESENTATIVES	DATE	INITIALS
MEP. COORDINATOR		
MECHANICAL ENGINEER		
ELECTRICAL ENGINEER		

PROJECT:

**RESIDENTIAL BUILDING
G+1P+7+ROOF**

REVIEW STATUS: A B C D

DATE REVIEWED:

REVIEWED BY:

DATE:

Rev	Date	Description	Drawn	Checked
AB	02/11/2019	AS BUILT DRAWING SUBMISSION	RCF	Engr. Hazem

CLIENT:

**MR. MASOOD ABDULLA MOHD
ABDULAZIZ AL ZAROONI**

LOCATION	PLOT No.
IC- PHASE 3	IC3-H-40

PRINCIPAL CONSULTANT:

OFFICE 2601, THE EXCHANGE TOWER
BUSINESS BAY - DUBAI - U.A.E
TEL: 04-2777828 P.O. BOX: 237347
www.naarchitects.net

MAIN CONTRACTOR:

SUB CONTRACTOR:

DRAWING TITLE:

ROOF FLOOR PLAN

DRAWN BY: RCF	JOB NO: P-10	DATE: 02.11.2019
CHECKED BY: Engr. Hazem	SCALE: 1:100	SHEET SIZE: A1
PROJECT NO: NA/IC/B103 NA/IC/B103/15	SHOP DRAWING NO:	REV: AB

AS BUILT



- GENERAL NOTES**
- THIS DRAWING IS THE PROPERTY OF :
na architects engineering consultancy
P.O.Box 237347, DUBAI.
IT IS FORBIDDEN TO PRODUCE IT'S CONTENTS IN ANY FORM, EXCEPT FOR THE INTENDED PURPOSE.
 - THIS DRAWING IS NOT TO BE SCALED. THE STATED DIMENSIONS ONLY ARE TO BE CONSIDERED.
 - THE DISCREPANCIES ARE TO BE BROUGHT TO THE ATTENTION AND RESOLVED BY NA ARCHITECTS ENGINEERING CONSULTANCY BEFORE COMMENCEMENT OF ANY WORK.
 - ALWAYS FOLLOWED WRITTEN DIMENSION.

LEGEND

KEY PLAN

AS BUILT

CONTRACTORS REPRESENTATIVES	DATE	INITIALS
CM / PROJECT ENGINEER		
ARCHITECT		
STRUCTURAL ENGINEER		
SUBCONTRACTORS REPRESENTATIVES	DATE	INITIALS
MEP. COORDINATOR		
MECHANICAL ENGINEER		
ELECTRICAL ENGINEER		

PROJECT: **RESIDENTIAL BUILDING G+1P+7+ROOF**

REVIEW STATUS: A B C D

DATE REVIEWED: _____

REVIEWED BY: _____

DATE: _____

Rev	Date	Description	Drawn	Checked
AB	02/11/2019	AS BUILT DRAWING SUBMISSION	RCF	Engr. Hazem

CLIENT: **MR. MASOOD ABDULLA MOHD ABDULAZIZ AL ZAROONI**

LOCATION: **IC- PHASE 3** PLOT No. **IC3-H-40**

PRINCIPAL CONSULTANT:

ان ايه ار كيمكن للاستشارات الهندسية
NA ARCHITECTS ENGINEERING CONSULTANCY
OFFICE 2601 / THE EXCHANGE TOWER
BUSINESS BAY - DUBAI - U.A.E
TEL: 04-2777820 P.O.BOX- 237347
www.naarchitects.net

MAIN CONTRACTOR:

ALMABNA CONTRACTING COMPANY
2601-01
TEL: 04-2777820
FAX: 04-2777820
P.O.Box: 237347

SUB CONTRACTOR:


ALMABNA CONTRACTING COMPANY
2601-01
TEL: 04-2777820
FAX: 04-2777820
P.O.Box: 237347

DRAWING TITLE: **ELEVATION 1**




DRAWN BY: **RCF** JOB NO: **P-10** DATE: **02.11.2019**

CHECKED BY: **Engr. Hazem** SCALE: **1:100** SHEET SIZE: **A1**


PROJECT NO: **NA/IC/B103** SHOP DRAWING NO: _____ REV: **AB**

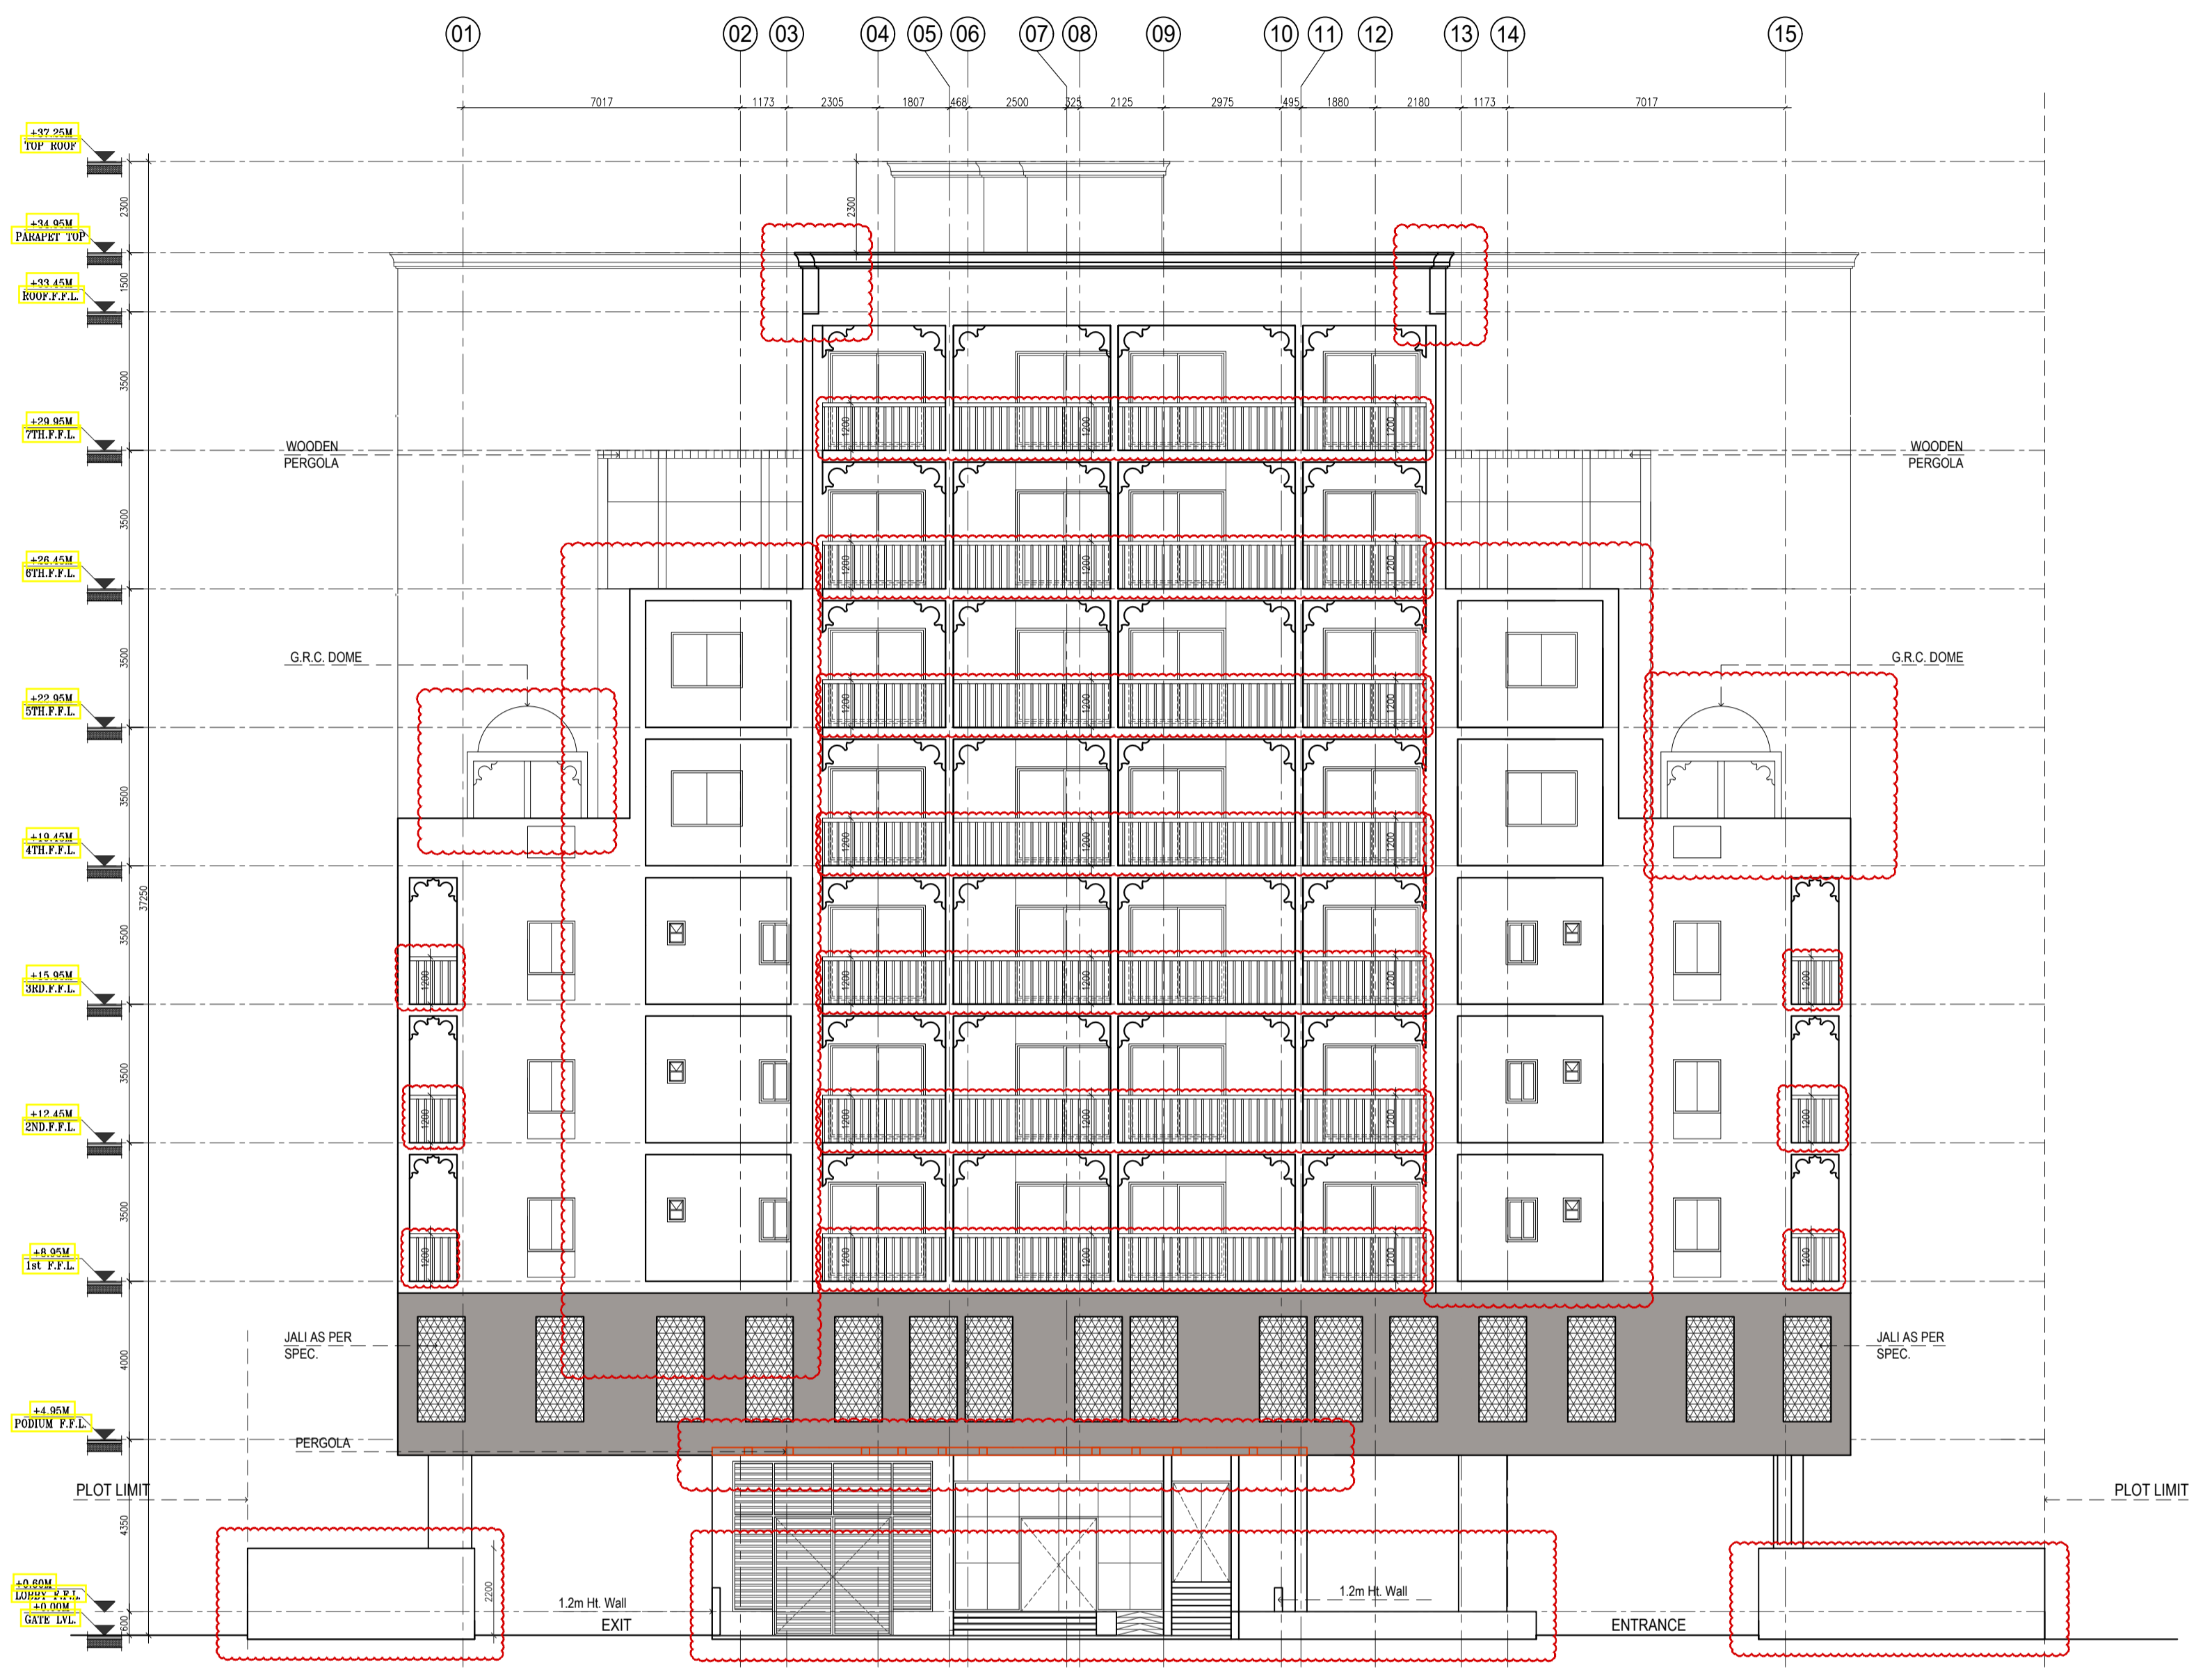

A ELEVATION 1
A-201 1:100

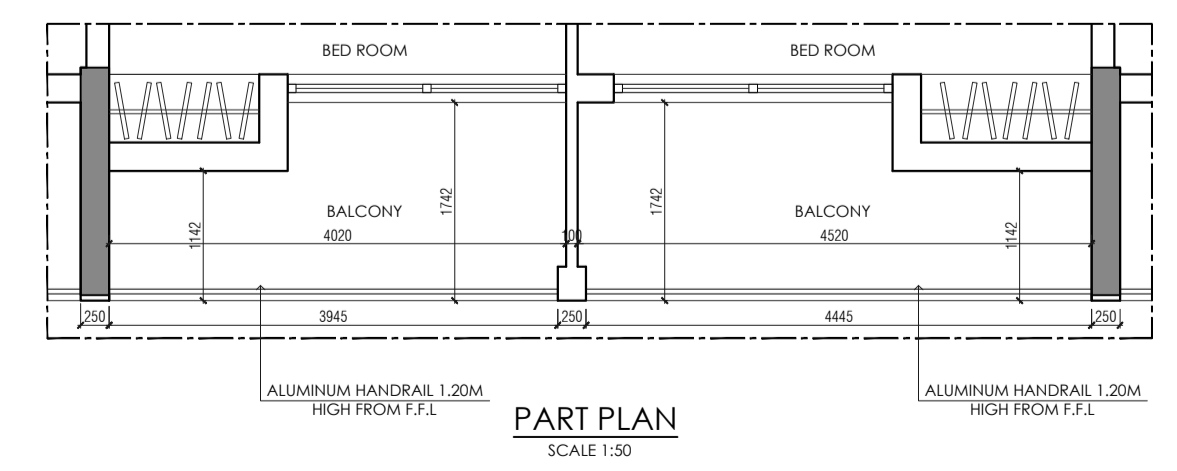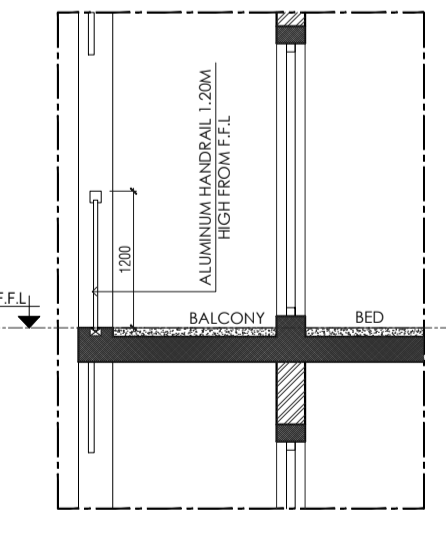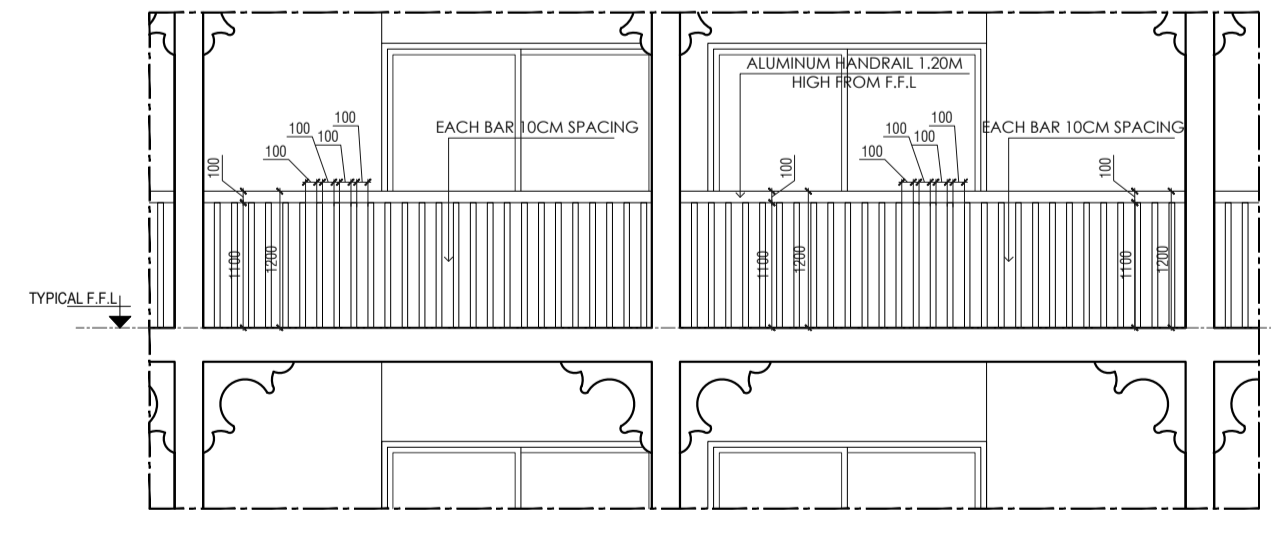

AS BUILT

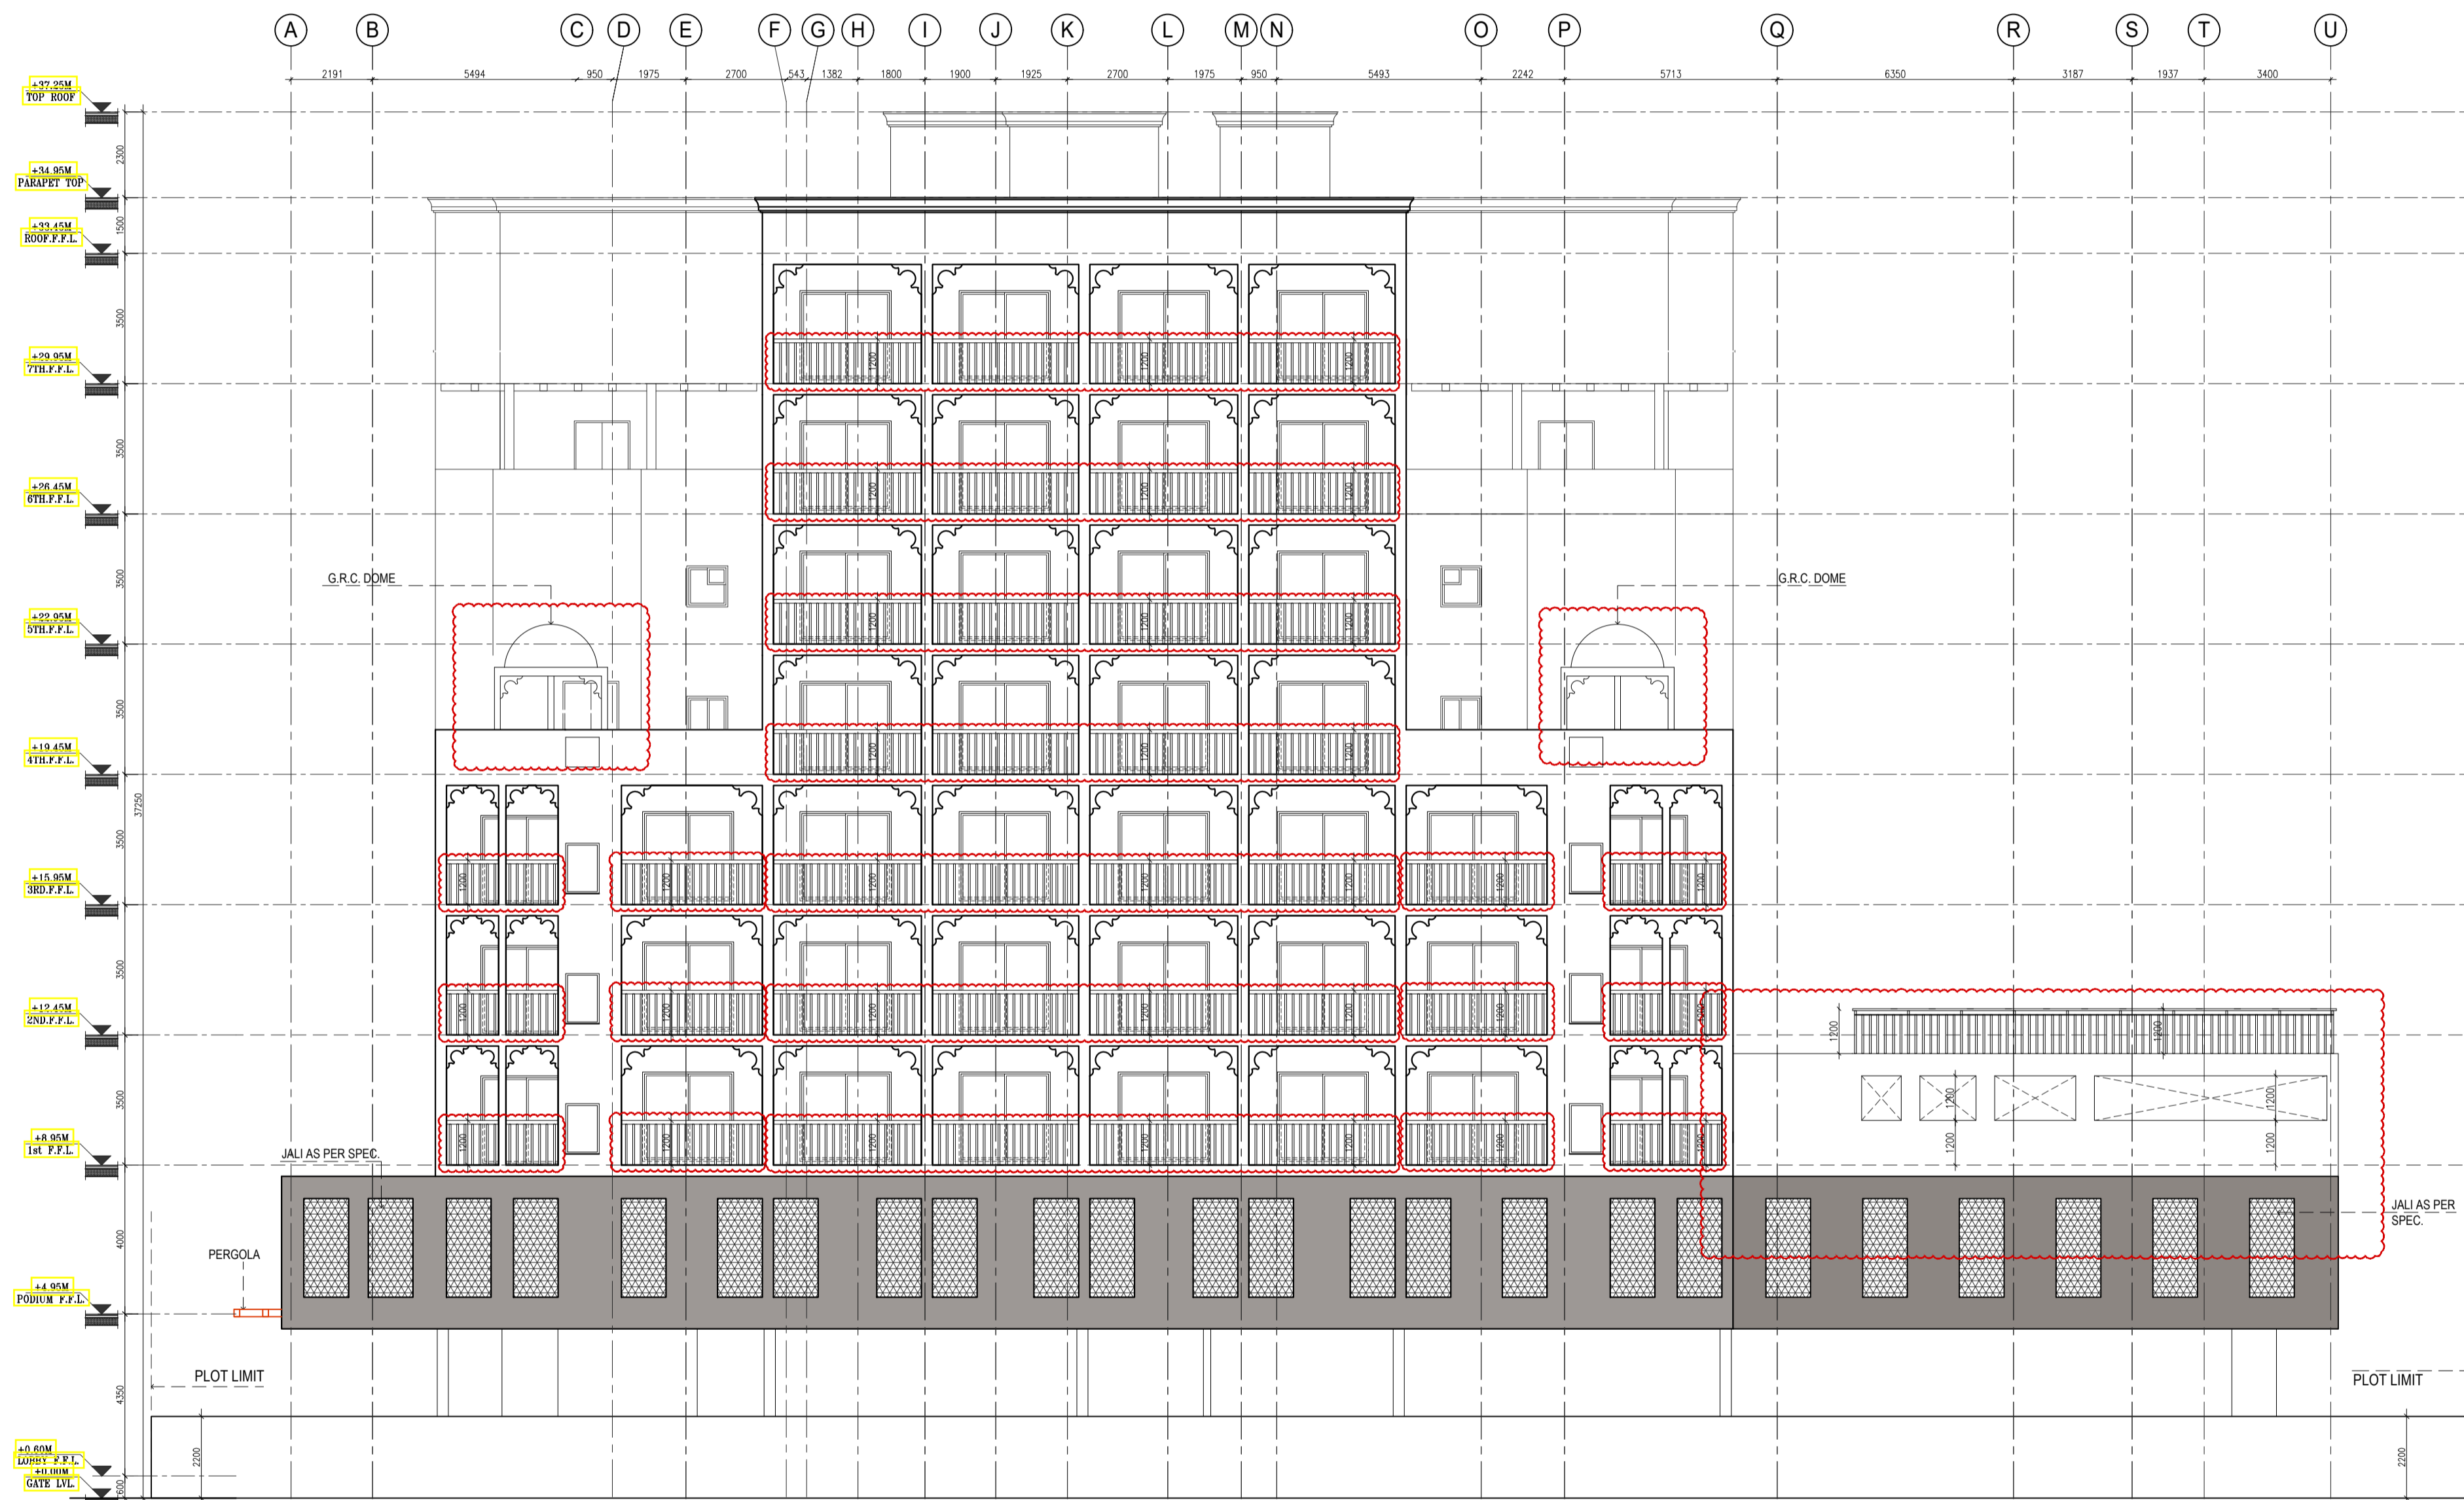

A ELEVATION 2
A-202 1:100

GENERAL NOTES

1. THIS DRAWING IS THE PROPERTY OF :
na architects engineering consultancy
P.O.Box: 237347, DUBAI.
IT IS FORBIDDEN TO PRODUCE IT'S CONTENTS IN ANY FORM, EXCEPT FOR THE INTENDED PURPOSE.
2. THIS DRAWING IS NOT TO BE SCALED. THE STATED DIMENSIONS ONLY ARE TO BE CONSIDERED.
3. THE DISCREPANCIES ARE TO BE BROUGHT TO THE ATTENTION AND RESOLVED BY NA ARCHITECTS ENGINEERING CONSULTANCY BEFORE COMMENCEMENT OF ANY WORK.
4. ALWAYS FOLLOWED WRITTEN DIMENSION.

LEGEND

KEY PLAN

AS BUILT

CONTRACTORS REPRESENTATIVES	DATE	INITIALS
CM / PROJECT ENGINEER		
ARCHITECT		
STRUCTURAL ENGINEER		
SUBCONTRACTORS REPRESENTATIVES	DATE	INITIALS
MEP. COORDINATOR		
MECHANICAL ENGINEER		
ELECTRICAL ENGINEER		

PROJECT:
**RESIDENTIAL BUILDING
G+1P+7+ROOF**

REVIEW STATUS	<input type="checkbox"/> A	<input type="checkbox"/> B	<input type="checkbox"/> C	<input type="checkbox"/> D
DATE REVIEWED				
REVIEWED BY				
DATE:				

Rev	Date	Description	Drawn	Checked
AB	02/11/2019	AS BUILT DRAWING SUBMISSION	RCF	Engr. Hazem

CLIENT:
**MR. MASOOD ABDULLA MOHD
ABDULAZIZ AL ZAROONI**

LOCATION	PLOT No.
IC- PHASE 3	IC3-H-40

PRINCIPAL CONSULTANT:

NA ARCHITECTS ENGINEERING CONSULTANCY
OFFICE 2601 - THE EXCHANGE TOWER
BUSINESS BAY - DUBAI - U.A.E
TEL: 04-2777820 P.O.BOX: 237347
www.naarchitects.ae

MAIN CONTRACTOR:

ALMABNA CONTRACTING COMPANY
P.O. BOX: 237347

SUB CONTRACTOR:

ALMABNA CONTRACTING COMPANY
P.O. BOX: 237347

DRAWING TITLE:
ELEVATION 2

DRAWN BY:	JOB NO:	DATE:
RCF	P-10	02.11.2019
CHECKED BY:	SCALE:	SHEET SIZE:
Engr. Hazem	1:100	A1

PROJECT NO:	SHOP DRAWING NO:	REV:
NA/IC/B103 NA/IC/B103/15		AB

AS BUILT



- GENERAL NOTES**
- THIS DRAWING IS THE PROPERTY OF :
na architects engineering consultancy
P.O.Box 237347, DUBAI.
IT IS FORBIDDEN TO PRODUCE IT'S CONTENTS IN ANY FORM, EXCEPT FOR THE INTENDED PURPOSE.
 - THIS DRAWING IS NOT TO BE SCALED. THE STATED DIMENSIONS ONLY ARE TO BE CONSIDERED.
 - THE DISCREPANCIES ARE TO BE BROUGHT TO THE ATTENTION AND RESOLVED BY NA ARCHITECTS ENGINEERING CONSULTANCY BEFORE COMMENCEMENT OF ANY WORK.
 - ALWAYS FOLLOWED WRITTEN DIMENSION.

LEGEND

KEY PLAN

AS BUILT

CONTRACTORS REPRESENTATIVES	DATE	INITIALS
CM / PROJECT ENGINEER		
ARCHITECT		
STRUCTURAL ENGINEER		
SUBCONTRACTORS REPRESENTATIVES	DATE	INITIALS
MEP. COORDINATOR		
MECHANICAL ENGINEER		
ELECTRICAL ENGINEER		

PROJECT:
**RESIDENTIAL BUILDING
G+1P+7+ROOF**

REVIEW STATUS	<input type="checkbox"/> A	<input type="checkbox"/> B	<input type="checkbox"/> C	<input type="checkbox"/> D
DATE REVIEWED				
REVIEWED BY				
DATE:				

Rev	Date	Description	Drawn	Checked
AB	02/11/2019	AS BUILT DRAWING SUBMISSION	RCF	Engr. Hazem

CLIENT :
**MR. MASOOD ABDULLA MOHD
ABDULAZIZ AL ZAROONI**

LOCATION	PLOT No.
IC- PHASE 3	IC3-H-40

PRINCIPAL CONSULTANT:

NA ARCHITECTS ENGINEERING CONSULTANCY
ان ايه اركيكتس الاستشارات الهندسية

OFFICE 2601 / THE EXCHANGE TOWER
BUSINESS BAY - DUBAI - U.A.E
TEL: 04-2777820 P.O.BOX: 237347
www.naarchitects.ae

MAIN CONTRACTOR :

MC **ALMABNA CONTRACTING COMPANY**


SUB CONTRACTOR :

MC **ALMABNA CONTRACTING COMPANY**

DRAWING TITLE :
ELEVATION 3


DRAWN BY:	JOB NO:	DATE:
RCF	P-10	02.11.2019
CHECKED BY:	SCALE:	SHEET SIZE:
Engr. Hazem	1:100	A1

PROJECT NO:	SHOP DRAWING NO:	REV:
NA/IC/B103 NA/IC/B103/15		AB

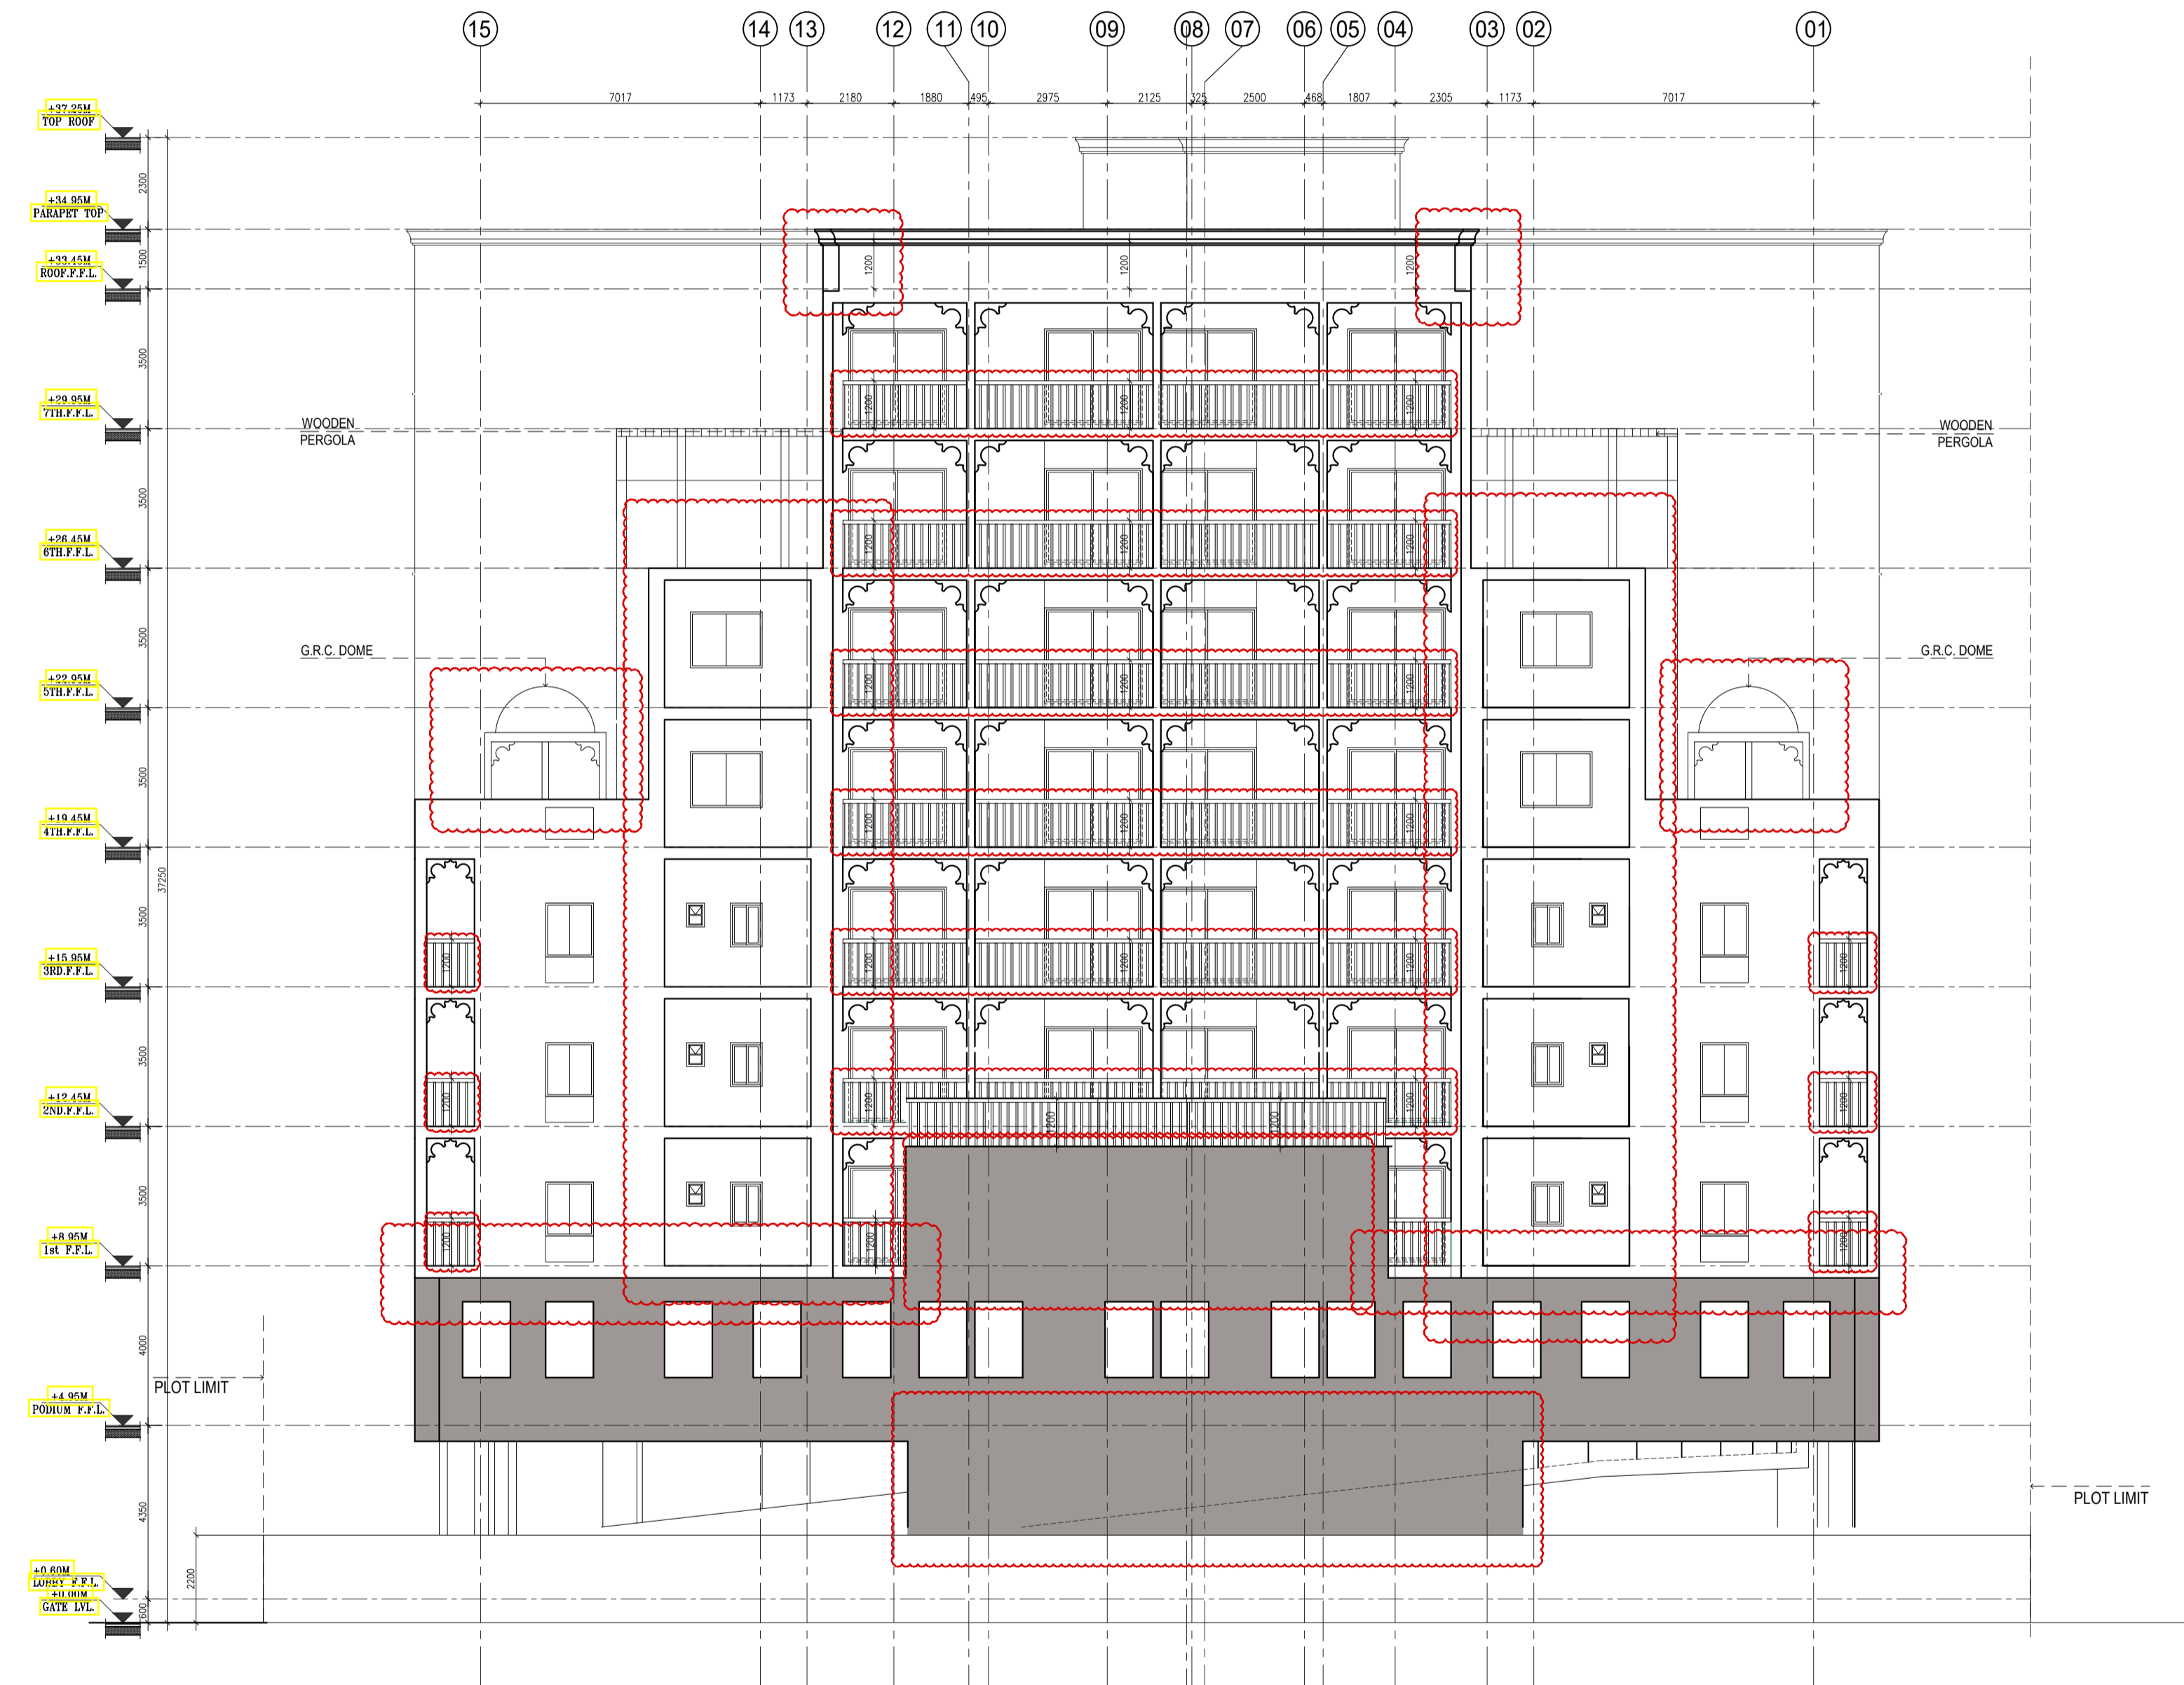

A ELEVATION 3
A-203 1:100

AS BUILT

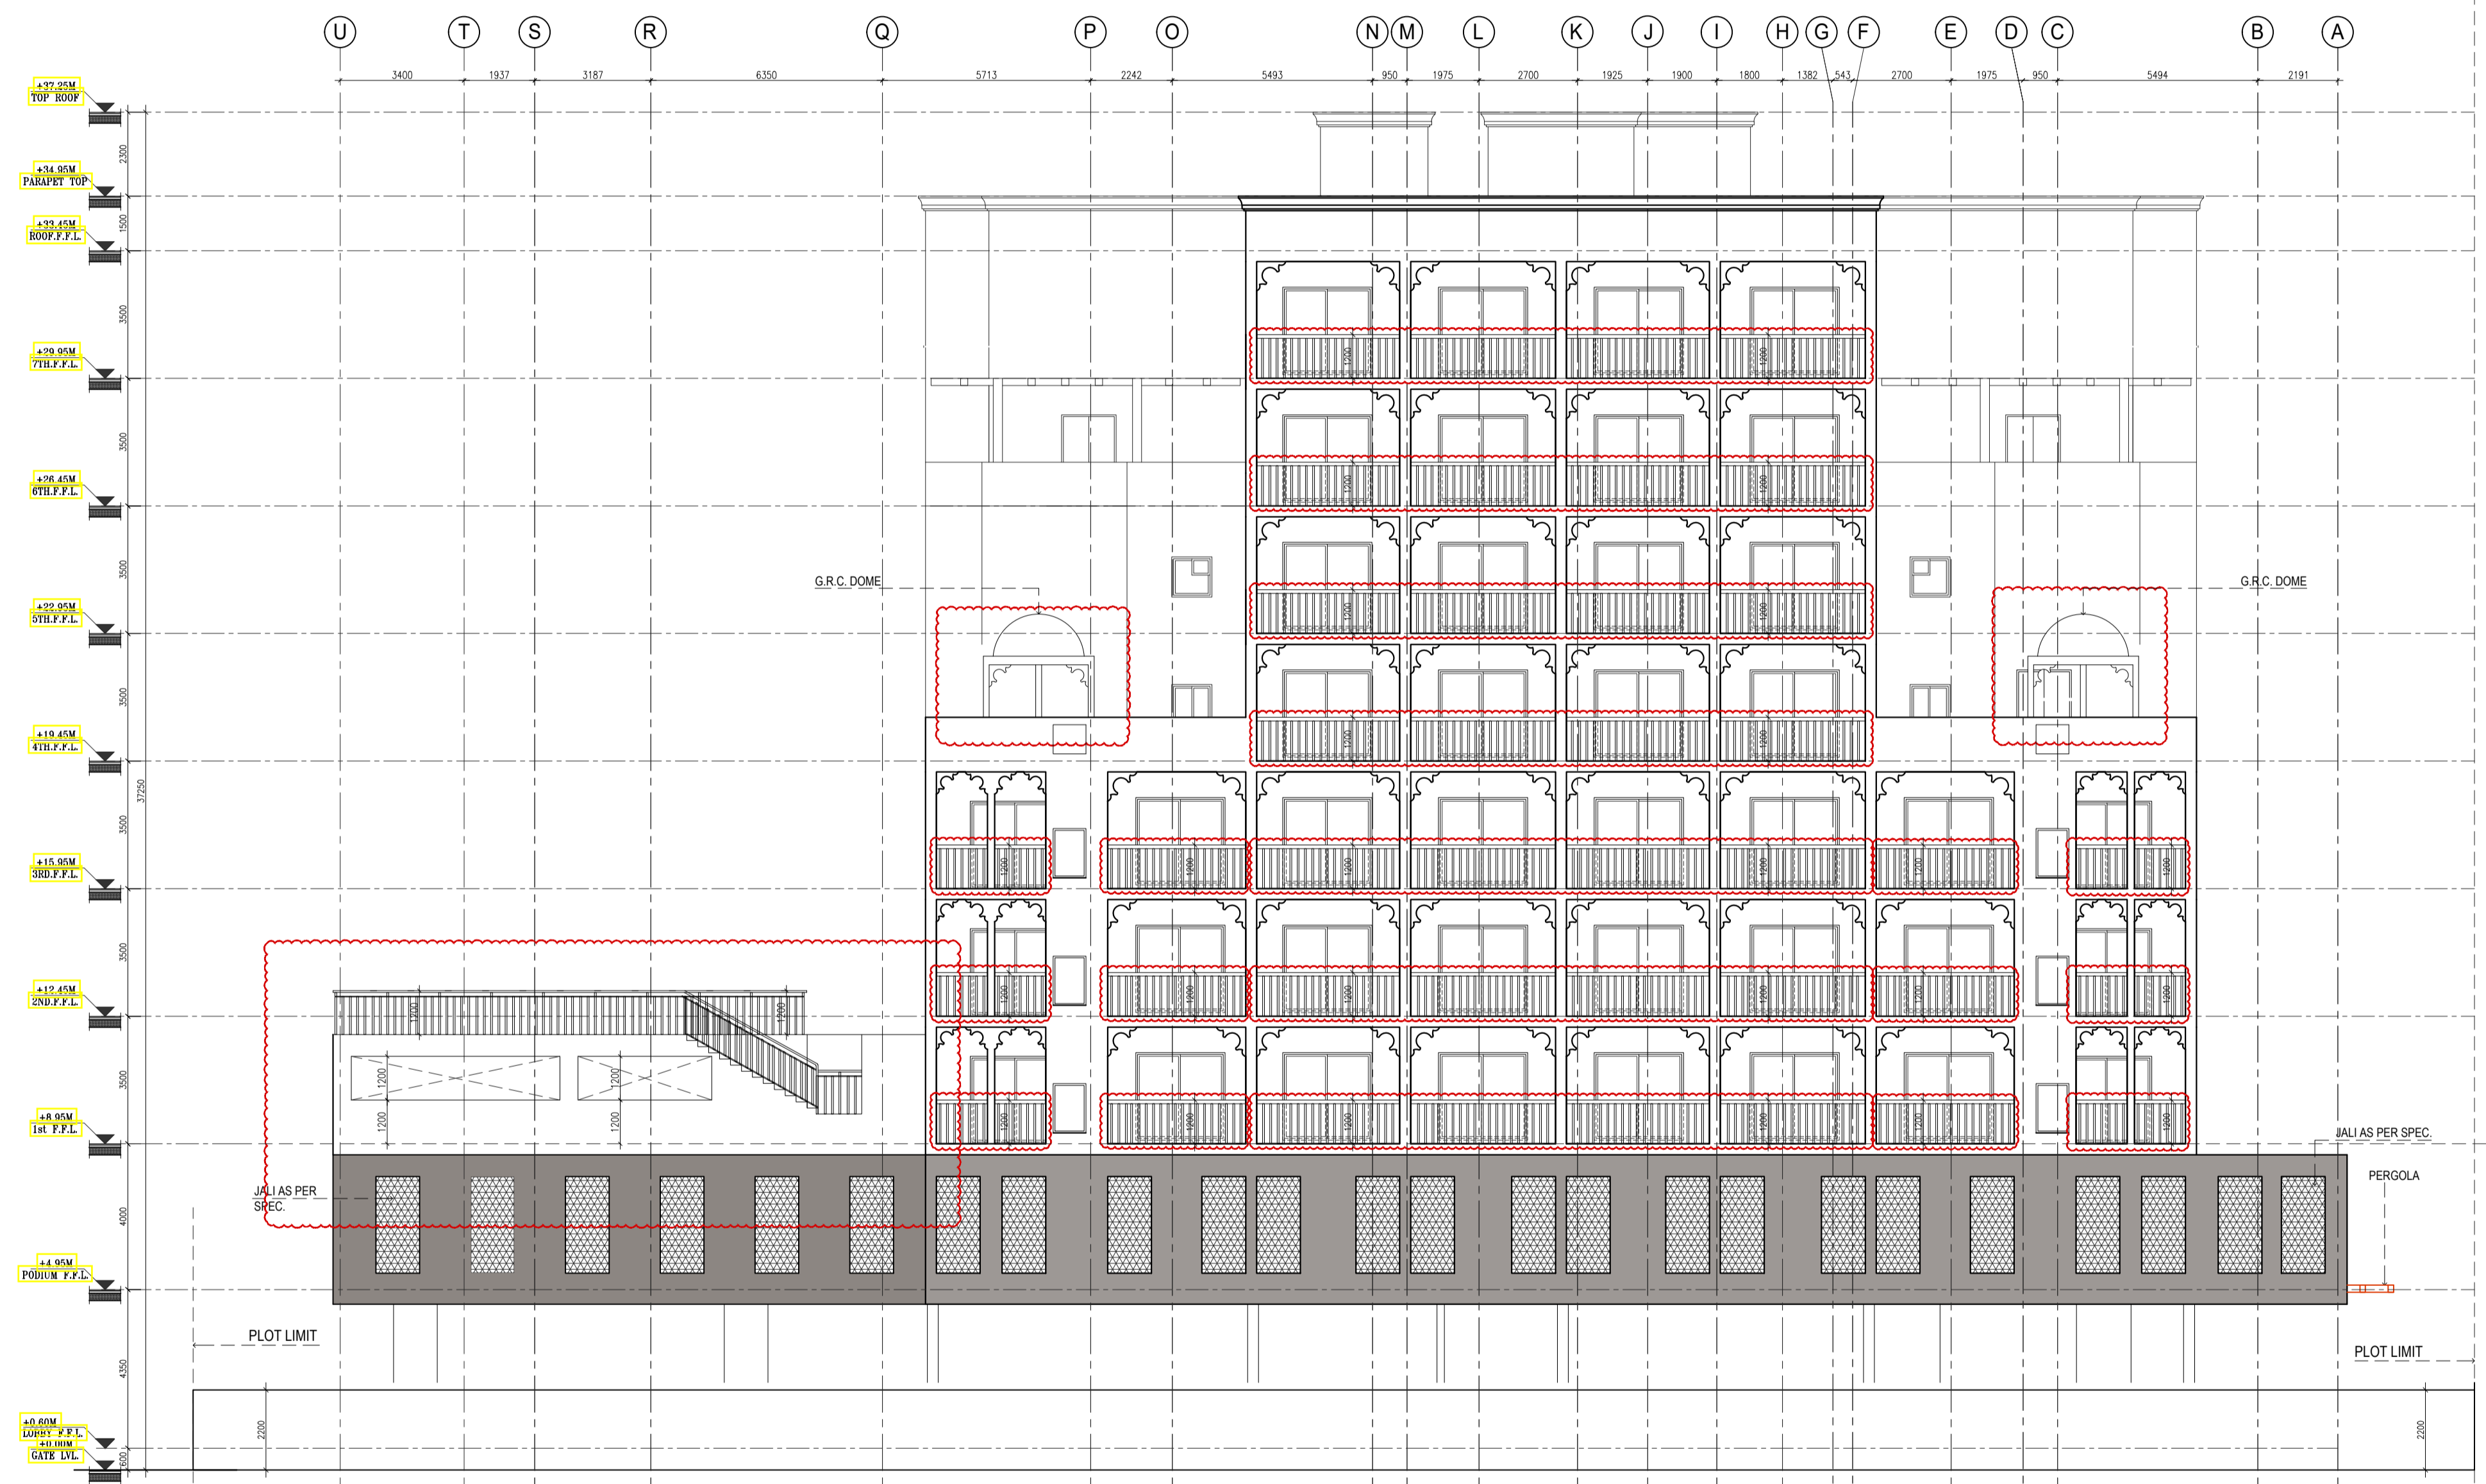

A ELEVATION 4
A-204 1:100

- GENERAL NOTES**
1. THIS DRAWING IS THE PROPERTY OF :
na architects engineering consultancy
P.O.Box 237347, DUBAI.
IT IS FORBIDDEN TO PRODUCE IT'S CONTENTS IN ANY FORM, EXCEPT FOR THE INTENDED PURPOSE.
 2. THIS DRAWING IS NOT TO BE SCALED. THE STATED DIMENSIONS ONLY ARE TO BE CONSIDERED.
 3. THE DISCREPANCIES ARE TO BE BROUGHT TO THE ATTENTION AND RESOLVED BY NA ARCHITECTS ENGINEERING CONSULTANCY BEFORE COMMENCEMENT OF ANY WORK.
 4. ALWAYS FOLLOWED WRITTEN DIMENSION.

LEGEND

KEY PLAN

AS BUILT

CONTRACTORS REPRESENTATIVES	DATE	INITIALS
CM / PROJECT ENGINEER		
ARCHITECT		
STRUCTURAL ENGINEER		
SUBCONTRACTORS REPRESENTATIVES	DATE	INITIALS
MEP. COORDINATOR		
MECHANICAL ENGINEER		
ELECTRICAL ENGINEER		

PROJECT:
**RESIDENTIAL BUILDING
G+1P+7+ROOF**

REVIEW STATUS	<input type="checkbox"/> A <input type="checkbox"/> B <input type="checkbox"/> C <input type="checkbox"/> D
DATE REVIEWED	
REVIEWED BY	
DATE:	

Rev	Date	Description	Drawn	Checked
AB	02/11/2019	AS BUILT DRAWING SUBMISSION	RCF	Engr. Hazem

CLIENT :
**MR. MASOOD ABDULLA MOHD
ABDULAZIZ AL ZAROONI**

LOCATION IC- PHASE 3	PLOT No. IC3-H-40
-------------------------	----------------------

PRINCIPAL CONSULTANT:

OFFICE 2801 THE EXCHANGE TOWER
BUSINESS BAY - DUBAI - U.A.E
TEL: 04-2777820 P.O. BOX - 237347
www.naarchitects.net

MAIN CONTRACTOR :

SUB CONTRACTOR :

DRAWING TITLE:
ELEVATION 4

DRAWN BY: RCF	JOB NO: P-10	DATE: 02.11.2019
CHECKED BY: Engr. Hazem	SCALE: 1:100	SHEET SIZE: A1
PROJECT NO: NA/IC/B103 NA/IC/B103/15	SHOP DRAWING NO:	REV: AB

AS BUILT

- GENERAL NOTES**
1. THIS DRAWING IS THE PROPERTY OF :
na architects engineering consultancy
P.O.Box 237347, DUBAI.
IT IS FORBIDDEN TO PRODUCE IT'S CONTENTS IN ANY FORM, EXCEPT FOR THE INTENDED PURPOSE.
 2. THIS DRAWING IS NOT TO BE SCALED. THE STATED DIMENSIONS ONLY ARE TO BE CONSIDERED.
 3. THE DISCREPANCIES ARE TO BE BROUGHT TO THE ATTENTION AND RESOLVED BY NA ARCHITECTS ENGINEERING CONSULTANCY BEFORE COMMENCEMENT OF ANY WORK.
 4. ALWAYS FOLLOWED WRITTEN DIMENSION.

LEGEND

KEY PLAN



AS BUILT

CONTRACTORS REPRESENTATIVES	DATE	INITIALS
CM / PROJECT ENGINEER		
ARCHITECT		
STRUCTURAL ENGINEER		
SUBCONTRACTORS REPRESENTATIVES	DATE	INITIALS
MEP. COORDINATOR		
MECHANICAL ENGINEER		
ELECTRICAL ENGINEER		

PROJECT:
**RESIDENTIAL BUILDING
G+1P+7+ROOF**

REVIEW STATUS	<input type="checkbox"/> A	<input type="checkbox"/> B	<input type="checkbox"/> C	<input type="checkbox"/> D
DATE REVIEWED				
REVIEWED BY				
DATE:				

Rev	Date	Description	Drawn	Checked
AB	02/11/2019	AS BUILT DRAWING SUBMISSION	RCF	Engr. Hazem

CLIENT:
**MR. MASOOD ABDULLA MOHD
ABDULAZIZ AL ZAROONI**


LOCATION IC- PHASE 3	PLOT No. IC3-H-40
-------------------------	----------------------

PRINCIPAL CONSULTANT:
ان ايه آر كينكتس للاستشارات الهندسية
 NA ARCHITECTS ENGINEERING CONSULTANCY
 OFFICE 2601 / THE EXCHANGE TOWER
 BUSINESS BAY - DUBAI - U.A.E
 TEL: 04-2777820 P.O.BOX- 237347
 www.naarchitects.net

MAIN CONTRACTOR:	MC ALMABNA CONTRACTING COMPANY
SUB CONTRACTOR:	MC ALMABNA CONTRACTING COMPANY


DRAWING TITLE:
SECTION A-A

DRAWN BY: RCF	JOB NO: P-10	DATE: 02.11.2019
CHECKED BY: Engr. Hazem	SCALE: 1:100	SHEET SIZE: A1
PROJECT NO: NA/IC/B103 NA/IC/B103/15	SHOP DRAWING NO:	REV: AB

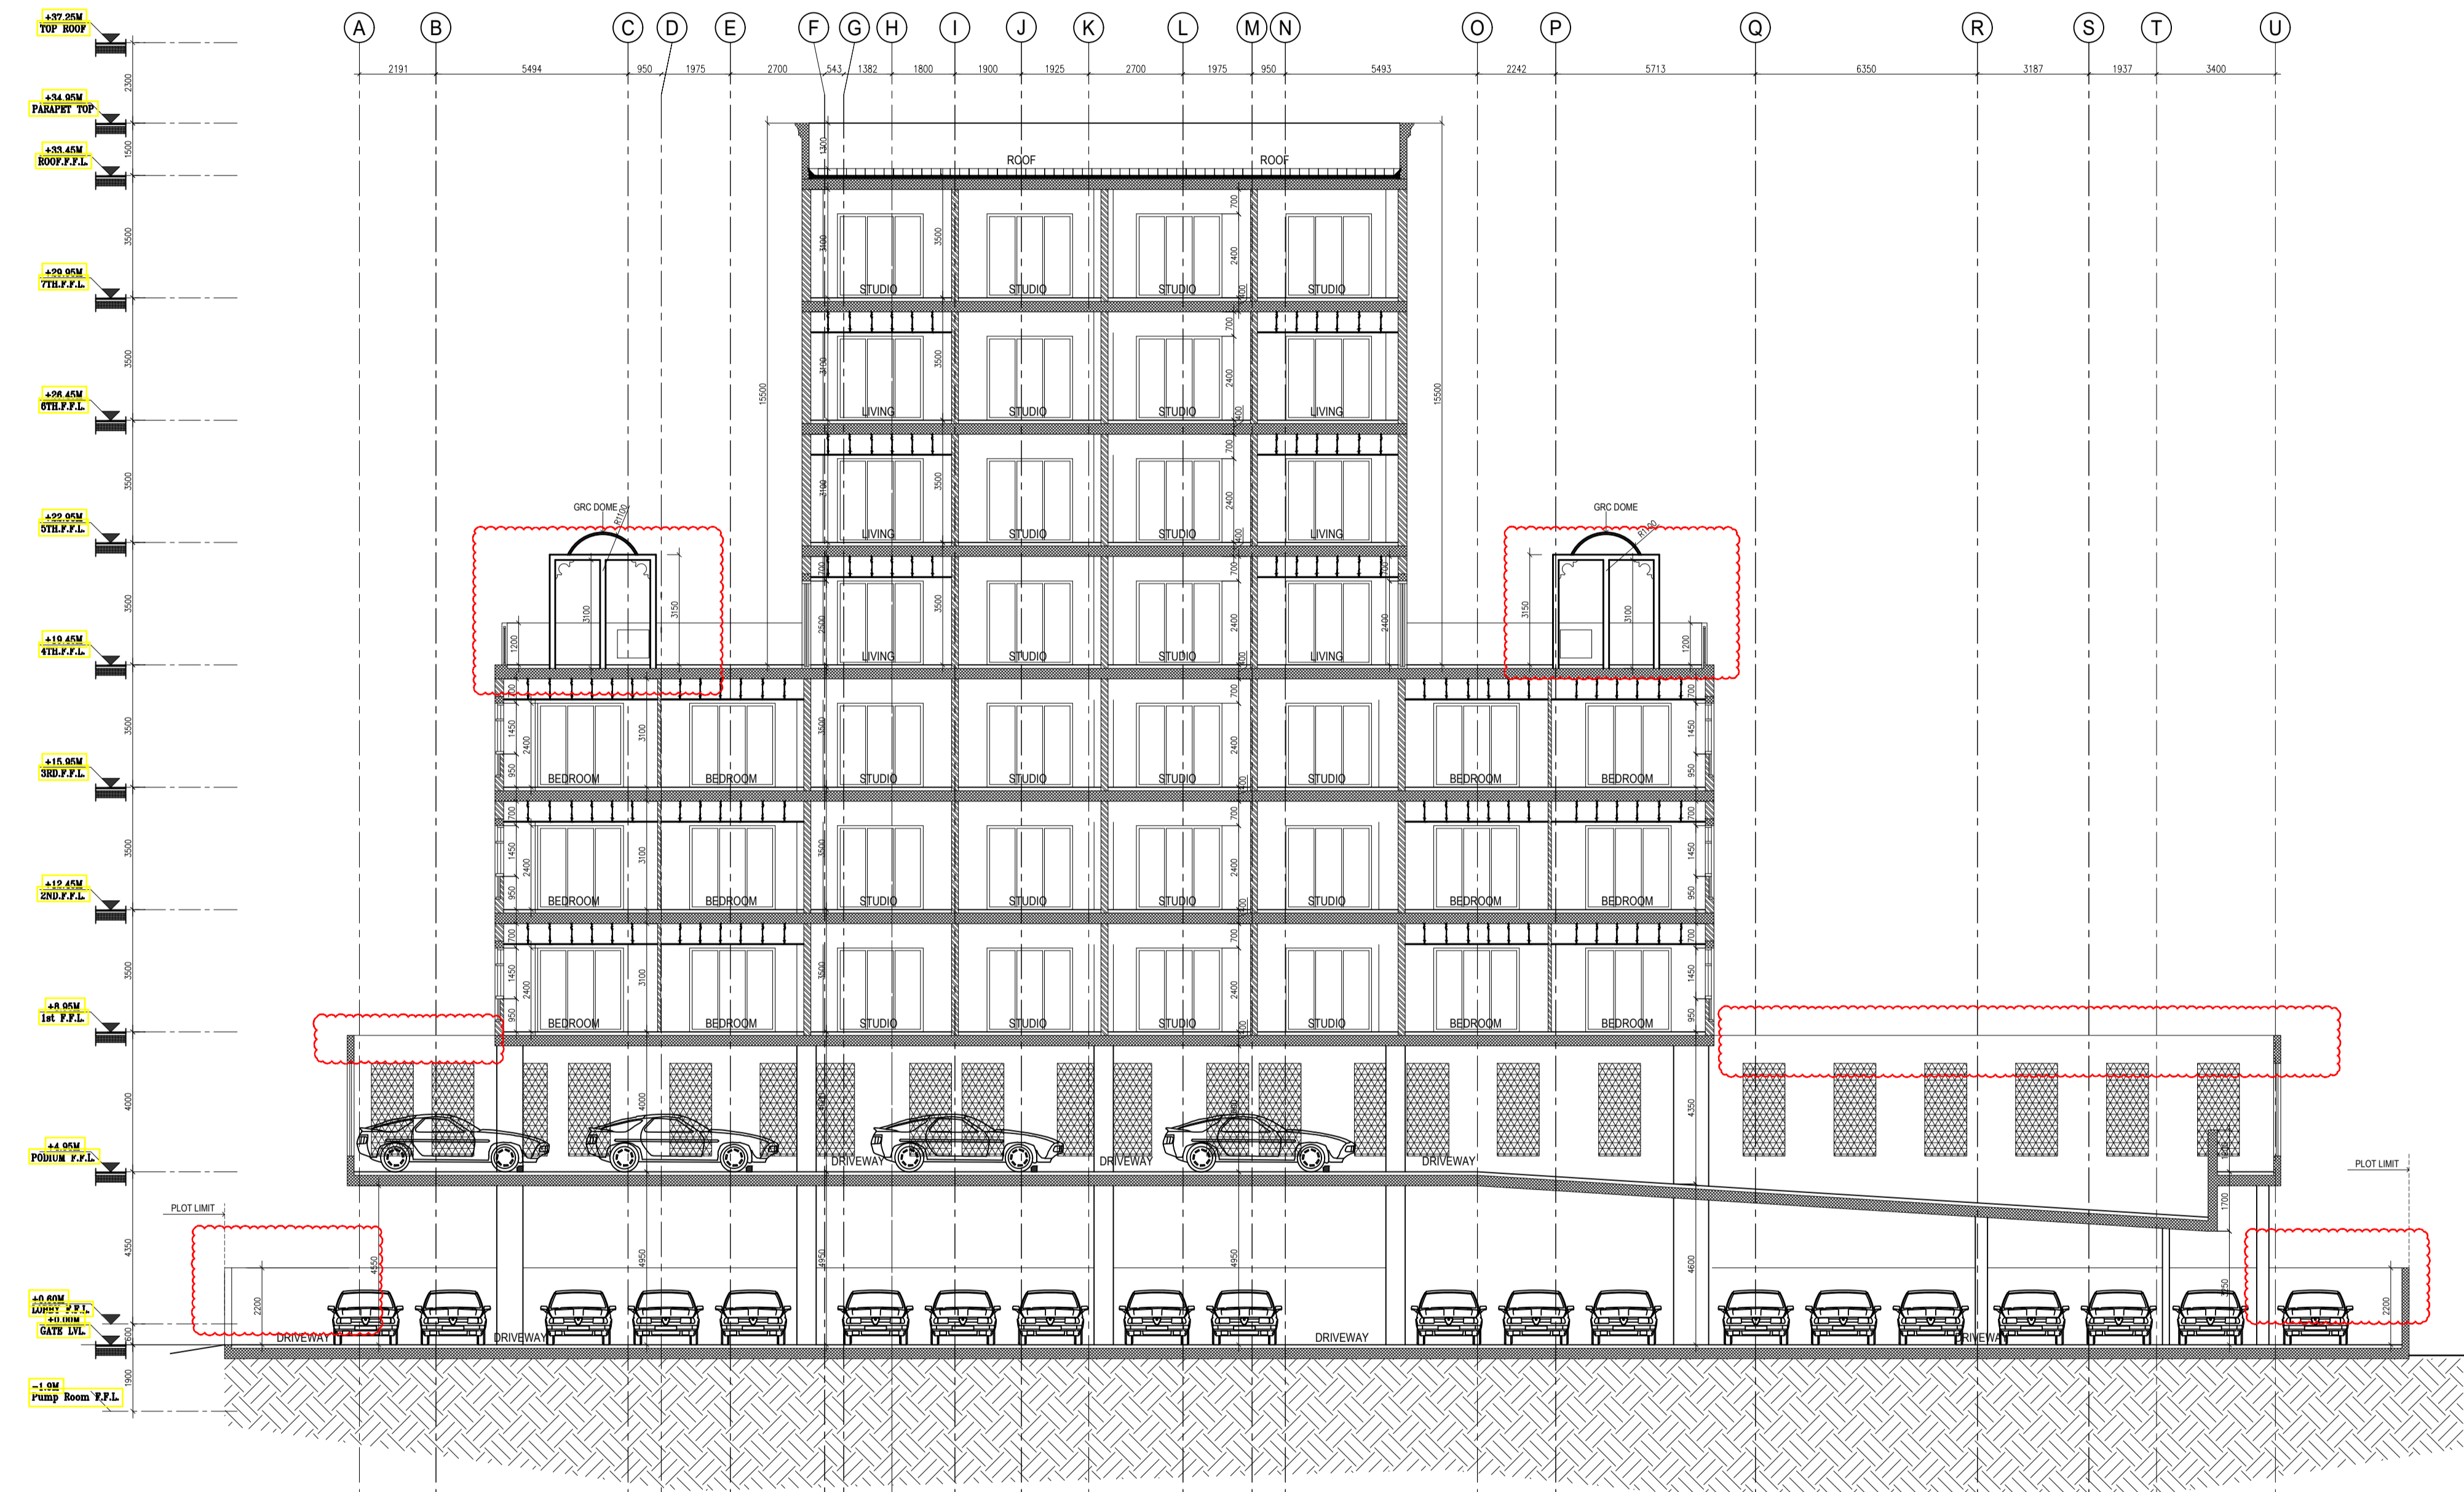

A SECTION- AA
A-301 1:100

AS BUILT

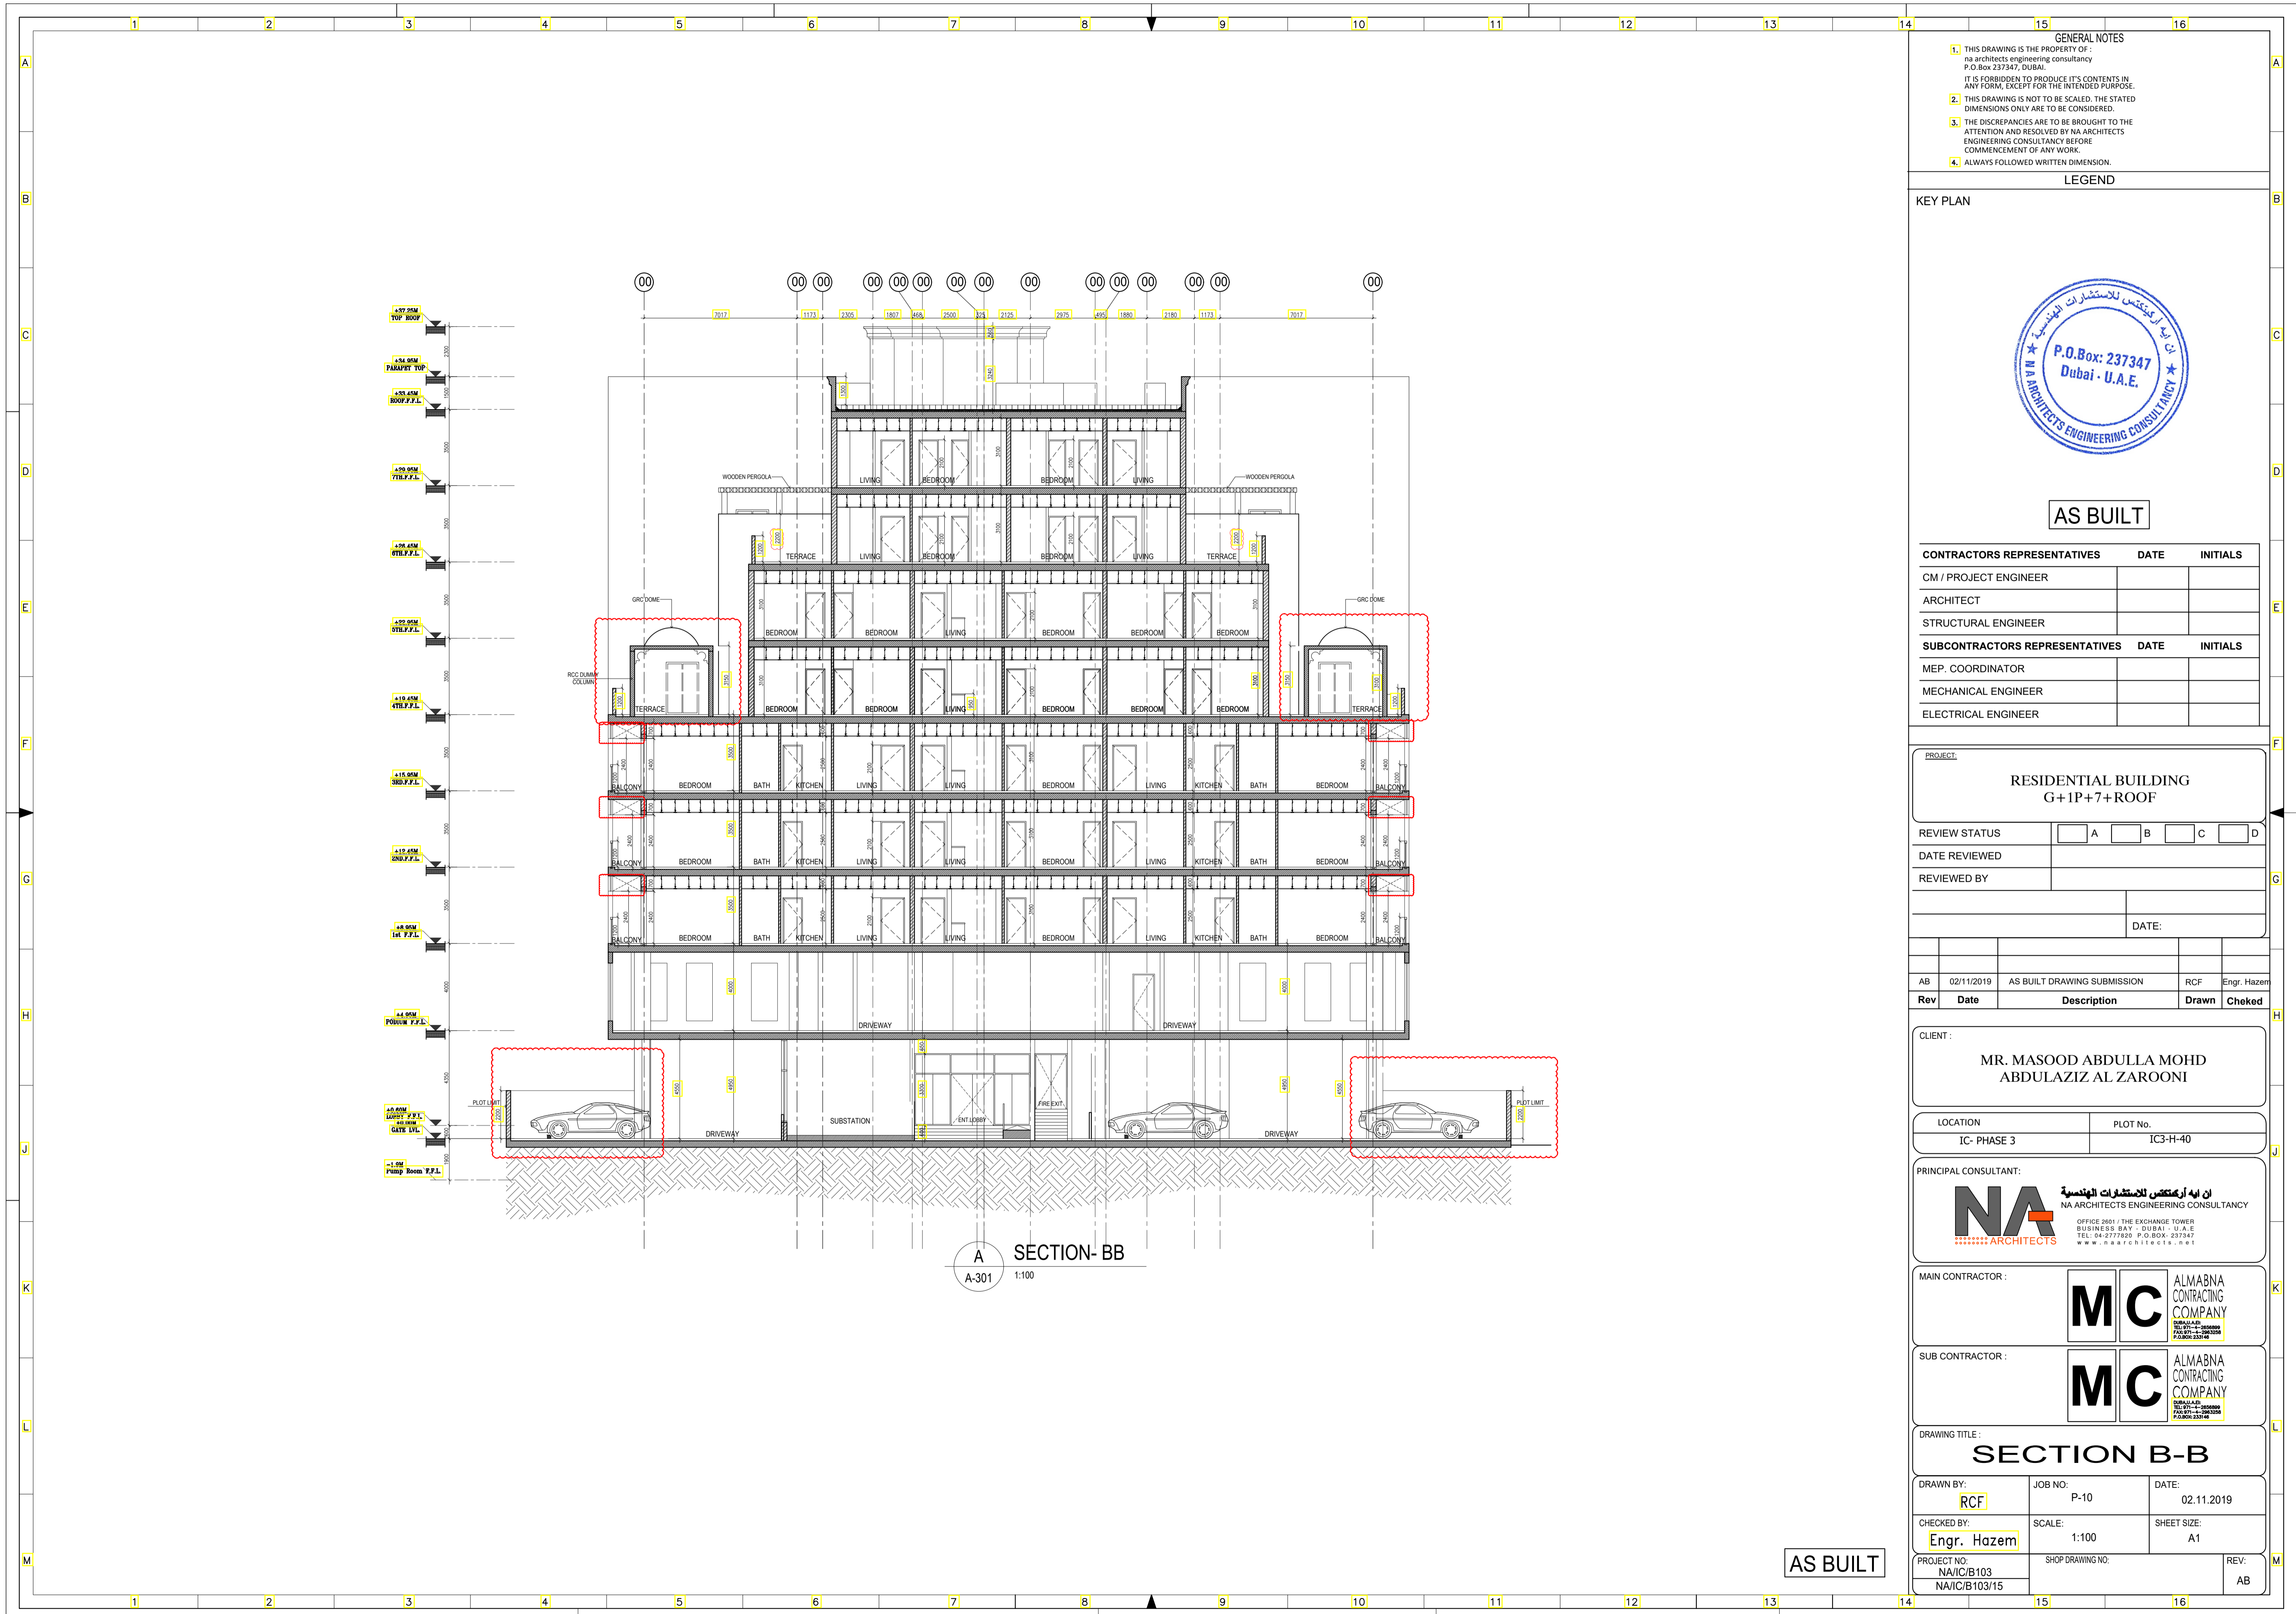

A SECTION-B-B
A-301 1:100

AS BUILT

- GENERAL NOTES
1. THIS DRAWING IS THE PROPERTY OF :
na architects engineering consultancy
P.O.Box 237347, DUBAI.
IT IS FORBIDDEN TO PRODUCE IT'S CONTENTS IN ANY FORM, EXCEPT FOR THE INTENDED PURPOSE.
 2. THIS DRAWING IS NOT TO BE SCALED. THE STATED DIMENSIONS ONLY ARE TO BE CONSIDERED.
 3. THE DISCREPANCIES ARE TO BE BROUGHT TO THE ATTENTION AND RESOLVED BY NA ARCHITECTS ENGINEERING CONSULTANCY BEFORE COMMENCEMENT OF ANY WORK.
 4. ALWAYS FOLLOWED WRITTEN DIMENSION.

LEGEND

KEY PLAN



AS BUILT

CONTRACTORS REPRESENTATIVES	DATE	INITIALS
CM / PROJECT ENGINEER		
ARCHITECT		
STRUCTURAL ENGINEER		
SUBCONTRACTORS REPRESENTATIVES	DATE	INITIALS
MEP. COORDINATOR		
MECHANICAL ENGINEER		
ELECTRICAL ENGINEER		

PROJECT:
RESIDENTIAL BUILDING
G+1P+7+ROOF

REVIEW STATUS	<input type="checkbox"/> A	<input type="checkbox"/> B	<input type="checkbox"/> C	<input type="checkbox"/> D
DATE REVIEWED				
REVIEWED BY				
DATE:				

Rev	Date	Description	Drawn	Checked
AB	02/11/2019	AS BUILT DRAWING SUBMISSION	RCF	Engr. Hazem

CLIENT :
MR. MASOOD ABDULLA MOHD
ABDULAZIZ AL ZAROONI

LOCATION IC- PHASE 3	PLOT No. IC3-H-40
-------------------------	----------------------

PRINCIPAL CONSULTANT:

OFFICE 2601 THE EXCHANGE TOWER
BUSINESS BAY - DUBAI - U.A.E
TEL: 04-2777820 P.O. BOX: 237347
www.naarchitects.net

MAIN CONTRACTOR :

SUB CONTRACTOR :

DRAWING TITLE:
SECTION B-B

DRAWN BY: RCF	JOB NO: P-10	DATE: 02.11.2019
CHECKED BY: Engr. Hazem	SCALE: 1:100	SHEET SIZE: A1
PROJECT NO: NA/IC/B103 NA/IC/B103/15	SHOP DRAWING NO:	REV: AB